

DEC 14 4 07 PM '94

REGISTER OF DEEDS
SAGINAW COUNTY MICH.

APPROVED BY PEER GROUP
P.A. 345 OF 1990 SAGINAW COUNTY REMONUMENTATION PROJECT

SAGINAW COUNTY

LAND CORNER RECORDATION CERTIFICATE

Filing Requirement of Act 74, Mich. P.A. 1970

For corners in SURVEY & REMONUMENTATION
Saginaw (County)

Corner Code #

1. Public Land Survey APR 24 1995 T 12N R 3E L-7
 COMMISSION T R
 T R
 2. Property Controlling S T R
 in Section S T R
 3. Miscellaneous S T R
 Property in Sec. S T R
4. Lot No. _____, Recorded Plat _____
 5. Private Claims _____

Lib 6 Page 223

Register of Deeds Stamp & File Number

I, John H. Rauser, in a field survey on May/June 19 94, do hereby certify that under requirements of P.A. 74, Michigan P.A. of 1970, the corner points mentioned in lines 1 and 2 above were in conformance with regulations and rules therefore as required in the current manual of survey instructions of the United States Department of the Interior, Bureau of Land Management or by a decree of a Court of Law and/or that the corner points mentioned in lines 3, 4 and 5 above were in conformance with the rules of the Michigan Board of Land Surveyors or by a Decree of a Court of Law; established, re-established, monumented, re-monumented, recovered, found as expressed below:

1	A	B	C	D	E	F	G	H	I	J	K	L	M
2	6	5	4	3	2	1							
3													
4	7	8	9	10	11	12							
5													
6	18	17	16	15	14	13							
7													
8	19	20	21	22	23	24							
9													
10	30	29	28	27	26	25							
11													
12	31	32	33	34	35	36							
13													

NOTE: Not more than 4 corners, all in the same town and range, may be recorded on this certificate.

A. Description of original monument and accessories and/or subsequent restoration:

- (L-7) 1/4 cor., Sec. 13 & 24, T12N-R3E
 Wood post placed by J. Wampler, Deputy Surveyor, 1822
 N06°E 41 lks. (27.06') 11" White Oak
 S48°W 10 lks. (6.6') 5" Aspen
 1926 Witnesses by Saginaw County Road Commission, Cedar Post and Stone.
 1971 Act 132 by John W. Martin, P.S. #4699, rec. in L. 1341, pg. _____, L. 1343, pg. 123-124, & L. 1352, pg. 876-876, Saginaw County Records.
 1972 L.C.R.C. by John W. Martin, P.S. #4699, rec. in L. 1, pg. 258, Saginaw County Records.
 1973 Act 132 by John W. Martin, P.S. #4699, rec. in L. 1395, pg. 1071, Saginaw County Records.
 1990 Act 132 by Ronald C. Prevost, P.S. #24612, rec. in L. 1764, pg. 1697-1698, Saginaw County Records.

B. Description of corner evidence found and/or method applied in restoring or reestablishing corner:


- (L-7) 1/4 cor., Sec. 13 & 24, T12N-R3E
 Found no evidence of original government corner.
 Found 4" x 3/4" chisel in mon. box at intersection of State and River Roads as per record as stated in "A" above and is accepted as the best available evidence of the position of the original corner.

C. Description of monument for corner and accessories established to perpetuate locating the position of the corner:

- (L-7) 1/4 cor., Sec. 13 & 24, T12N-R3E
 Set brass cap stamped Saginaw County Monument, P.S. #39096 in existing monument box.
 N60°W 64.45' Set PK w/tag #39096 in SW fce. Power Pole (fnd. old nail & tag 64.42')
 S62°W 59.65' Set PK w/tag #39096 in N. fce. Power Pole
 S51°E 89.89' (R=89.95') NW cor. conc. hse. foundation
 N66°E 124.51' SW cor. conc. hse. foundation at corner of hse. not entryway

Signed by John H. Rauser Date _____

Surveyor's Michigan License No. 39096

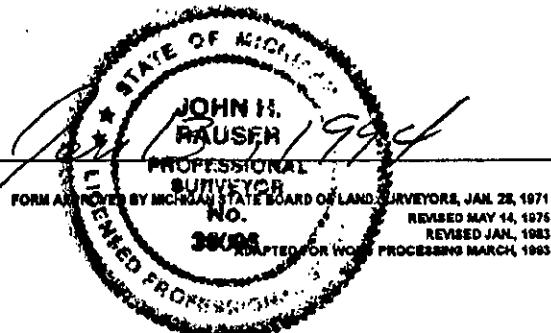

FORM APPROVED BY MICHIGAN STATE BOARD OF LAND SURVEYORS, JAN. 28, 1971
 REVISED MAY 14, 1976
 REVISED JAN. 1983
 ADAPTED FOR WORD PROCESSING MARCH, 1983