

RECORDED
& FILED

DEC 14 4 07 PM '94

REGISTER OF DEEDS
SAGINAW COUNTY MICH.

APPROVED BY PEER GROUP
P.A. 345 OF 1990
SAGINAW COUNTY
SAGINAW COUNTY REMONUMENTATION PROJECT
LAND CORNER RECORDATION CERTIFICATE
Filing Requirement of Act 74, Mich. P.A. 1970

9-23-94 [Signature]

For corners in Saginaw SURVEY & REMONUMENTATION Located In: _____ Corner Code # _____

1. Public Land Survey T-12N R-3E M-9
APR 24 1995
COMMISSION

2. Property Controlling in Section S _____ T _____ R _____
S _____ T _____ R _____

3. Miscellaneous Property in Sec. S _____ T _____ R _____

4. Lot No. _____ Recorded Plat _____

5. Private Claims _____

Liber 6 Page 238

Register of Deeds Stamp & File Number

	A	B	C	D	E	F	G	H	I	J	K	L	M
1													
2	6	5	4	3	2	1							
3													
4	7	8	9	10	11	12							
5													
6	18	17	16	15	14	13							
7													
8	19	20	21	22	23	24							
9													
10	30	29	28	27	26	25							
11													
12	31	32	33	34	35	36							
13													

I, John H. Rauser, in a field survey on October 19 94, do hereby certify that under requirements of P.A. 74, Michigan P.A. of 1970, the corner points mentioned in lines 1 and 2 above were in conformance with regulations and rules therefore as required in the current manual of survey instructions of the United States Department of the Interior, Bureau of Land Management or by a decree of a Court of Law and/or that the corner points mentioned in lines 3, 4 and 5 above were in conformance with the rules of the Michigan Board of Land Surveyors or by a Decree of a Court of Law; established, re-established, monumented, re-monumented, recovered, found as expressed below:

NOTE: Not more than 4 corners, all in the same town and range, may be recorded on this certificate.

A. Description of original monument and accessories and/or subsequent restoration:

(M-9) Standard Section Cor., Sec. 24 & 25, T12N-R3E
Wood post placed by J. Wampler, Deputy Surveyor 1822
S12°W 42 lks. (27.72') 40" White Oak
S79°E 3 1/2 lks. (2.31') 11" Beech

1972 Act 132 by John W. Martin, P.S. #4699 rec. L. 1375, pg. 634, Saginaw County Records.
1978 Act 132 by D. W. Hammond, P.S. #8890 rec. L. 1563, pg. 1280, Saginaw County Records.
1979 L.C.R.C. by D. W. Hammond, P.S. #8890 rec. L. 4, pg. 223, Saginaw County Records.
1982 Act 132 by Arthur H. Leach, P.S. #7236 rec. L. 1615, pg. 1282, Saginaw County Records.
1988 L.C.R.C. by Duane F. Ledy, P.S. #21575 rec. L. 1721, pg. 221, Saginaw County Records.
1993 L.C.R.C. by John H. Rauser, P.S. #39096 rec. L. 6, pg. 133 & L. 1882, pg. 1679 Saginaw County Records.


B. Description of corner evidence found and/or method applied in restoring or reestablishing corner:

(M-9) Standard Section Cor., Sec. 24 & 25, T12N-R3E
Found no evidence of original government corner. Found 3/4" pipe in mon. box as per record as stated in "A" above. Verified this corner as M-9, T12N-R3E in 1993. See L.C.R.C. rec. in L. 1882, pg. 1679, Saginaw County Records and is accepted as the best available evidence of the position of the original corner.

C. Description of monument for corner and accessories established to perpetuate locating the position of the corner:

(M-9) Standard Section Cor., Sec. 24 & 25, T12N-R3E
Reset 5/8" rerod w/brass cap stamped Saginaw County Monument, P.S. #39096 in existing Monument Box.
West 30.05' Fnd. PK w/tag #39096 in N. fc. Power Pole
East 37.95' Set spike w/tag #39096 in N. fc. Box Elder stump
East 55.99' Fnd. spike w/tag #39096 in S. fc. Power Pole
N28°W 69.95' Fnd. Chis. "+" in SE cor. sewer vault
S45°E 36.95' Fnd. Chis. "+" in W. rim sanitary manhole
South 1.98' A-9, T12N-R4E

Signed by John H. Rauser Date Jan 13 1995
Surveyor's Michigan License No. 39096

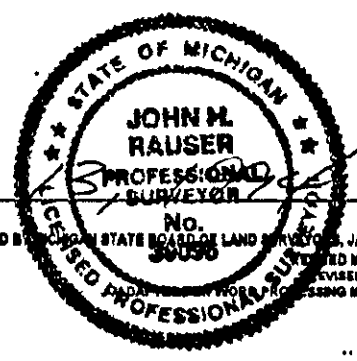

FORM APPROVED BY STATE BOARD OF LAND SURVEYORS, JAN. 26, 1971
REVISED MAY 14, 1975
REVISED JAN. 1983
REVISED MARCH, 1993