

DEC 15 1993

LAND CORNER RECORDATION CERTIFICATE

Filing Requirement of Act 74, Mich. P.A. 1970

Nov 24 2 02 PM '93

TITLE & BOOK REGISTER OF DEEDS SAGINAW COUNTY MICH.

Liber 6 Page 143

Register of Deeds Stamp & File Number

COMMISSION For corners in Saginaw (County)

Table with columns: Located In, Corner Code #. Rows include Public Land Survey, Property Controlling in Section, Miscellaneous Property in Sec., Lot No., and Private Claims.

Grid table with columns A-M and rows 2-13.

I, Ronald C. Prevost, in a field survey on Oct./Nov. 1993, do hereby certify that under requirements of P.A. 74, Michigan P.A. of 1970, the corner points mentioned in lines 1 and 2 above were in conformance with regulations and rules therefore as required in the current manual of survey instructions of the United States Department of the Interior, Bureau of Land Management or by a decree of a Court of Law and/or that the corner points mentioned in lines 3, 4 and 5 above were in conformance with the rules of the Michigan Board of Land Surveyors or by a Decree of a Court of Law; established, re-established, monumented, re-monumented, recovered, found as expressed below:

NOTE: Not more than 4 corners, all in the same town and range, may be recorded on this certificate.

A. Description of original monument and accessories and/or subsequent restoration:

- A-1 Post Set by J. Wampler in 1822. Rec'd as M-13, T.13 N.-R.3 E., Liber 3 Pg. 213, 1 1/2" Pipe. NE 66.9 Nail & Washer S. side P.P. NW 36.85 Stop Sign Post SW 51.3 Nail & Washer SE Side T. Pole Rec'd as A-13, T.13 N.-R.4 E., L5 P103, 5/8 Iron Pipe/Mon. Box SE 44.45 Face Stop Sign NW 40.55 Face Stop Sign SW 59.45 Ctr. Fire Hydrant


B. Description of corner evidence found and/or method applied in restoring or reestablishing corner:

- A-1 Found 1 1/2" Pipe in Mon. Box as per Liber 3, Pg. 213 & Liber 5, Pg 103 and is accepted as the best available evidence of the position of the original corner.

Ratified by Saginaw County Peer Review Group 9-23-93

C. Description of monument for corner and accessories established to perpetuate locating the position of the corner:

- A-1 Set 5/8" x 18" Re-bar with Saginaw Co. Re-mon Bronze Cap Stamped #24612 in Ex. Mon. Box in place of 1 1/2" pipe. Nail & Cap S. Face Power Pole N.50°E. 66.51 Drill Hole in Center S. End 72" CMP S.20°E. 37.54 Center Top. Hyd. S.35°W. 59.44 Nail & Cap in N. Face Light Pole S.50°W. 40.51

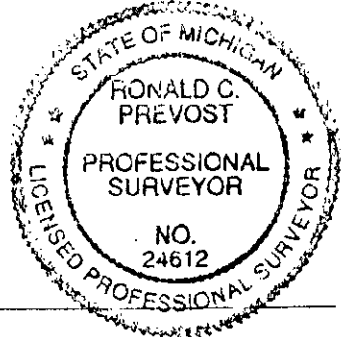

Signed by [Signature] Surveyor's Michigan License No. 24612

Date 11-24-93