

SAGINAW COUNTY REMONUMENTATION

SURVEY & REMONUMENTATION

LAND CORNER RECORDATION CERTIFICATE  
Filing Requirement of Act 74, Mich. P.A. 1970

DEC 15 1993

RECORDED

DEC 9 4 26 PM '93

HILDEGARD LUBDAN  
REGISTER OF DEEDS  
SAGINAW COUNTY MICH.

*Liber 6 Page 161*  
Register of Deeds Stamp & File Number

For corners in Saginaw (County) Located In: Corner Code #

1. Public Land Survey	T <u>12</u> N. R <u>4</u> E.	<u>A-3</u>
	T _____ R _____	_____
	T _____ R _____	_____
	T _____ R _____	_____
2. Property Controlling in Section	S _____ T _____ R _____	_____
	S _____ T _____ R _____	_____
3. Miscellaneous Property in Sec.	S _____ T _____ R _____	_____
	S _____ T _____ R _____	_____
4. Lot No. _____, Recorded Plat _____		
5. Private Claims _____		

A	B	C	D	E	F	G	H	I	J	K	L	M
2	6	5	4	3	2	1						
3												
4	7	8	9	10	11	12						
5												
6	18	17	16	15	14	13						
7												
8	19	20	21	22	23	24						
9												
10	30	29	28	27	26	25						
11												
12	31	32	33	34	35	36						
13												

I, Ronald C. Prevost, in a field survey on Oct./Dec, 19 93, do hereby certify that under requirements of P.A. 74, Michigan P.A. of 1970, the corner points mentioned in lines 1 and 2 above were in conformance with regulations and rules therefore as required in the current manual of survey instructions of the United States Department of the Interior, Bureau of Land Management or by a decree of a Court of Law and/or that the corner points mentioned in lines 3, 4 and 5 above were in conformance with the rules of the Michigan Board of Land Surveyors or by a Decree of a Court of Law; established, re-established, monumented, re-monumented, recovered, found as expressed below:

**NOTE: Not more than 4 corners, all in the same town and range, may be recorded on this certificate.**

A. Description of original monument and accessories and/or subsequent restoration:


- A-3 Post Set by J. Wampler in 1822.
- A-3 Co. Surveyor H. Cary, 1878, Stone Buried in Road, Large Oak Stake 31 Links North at NE Cor. Sec. 12, T.12 N.-R.3 E.
- A-3 Recorded Liber 2, Pg. 161, 3/4" Pipe. S.45°W., 44.95 Power Pole w/Nail in North Face N.45°E., 45.45 Util. Pole w/Nail in South Face N.30°W., 80.05 Power Pole w/Nail in East Face
- A-3 Recorded Liber 5, Pg. 14 3/4" Pipe. S.35°W., 44.70 to Face P. & T. Pole N.70°W., 80.00 to Face T. Pole S.80°W., 51.35 to Ctr. Hydrant S.30°W., 114.35 to Face 30" Maple North 20.00 to 3/4" Pipe, SE Cor., Sec. 1, T.12 N.-R.3 E.

B. Description of corner evidence found and/or method applied in restoring or reestablishing corner:

- A-3 Found 3/4" Pipe as per Liber 2 Pg. 161 and Liber 5, Pg. 14, and is accepted as the best available evidence of the position of the original corner.
- Ratified by Saginaw County Peer Review Group 9-23-93

C. Description of monument for corner and accessories established to perpetuate locating the position of the corner:

- A-3 Set 5/8" x 18" Bar with Saginaw Co. Bronze Cap Stamped #24612 & Mon. Box in place of 3/4" pipe is on line between M-3 & M-4, T.12 N.-R.3 E.
- North 200.00 to 3/4" Pipe SE Cor. Sec. 1, T.12 N.-R.3 E.
- Nail & Cap S. Face Power & T. Pole N.50°E. 78.96
- Nail & Cap S. Face Power & T. Pole N.70°E. 72.55
- Nail & Cap E. Face Power & T. Pole S.45°W. 48.06
- Hydrant S.80°W. 51.35

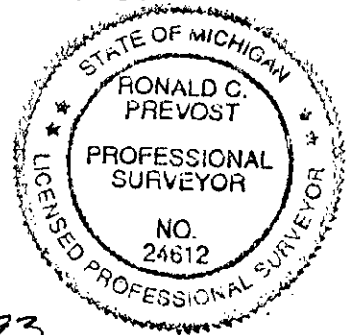

Signed by Ronald C. Prevost  
Surveyor's Michigan License No. 24612

Date 12-9-93