

SAGINAW COUNTY REMONUMENTATION

1993

COMMISSION

LAND CORNER RECORDATION CERTIFICATE
Filing Requirement of Act 74, Mich. P.A. 1970

RECORDED & FILED

For corners in
Saginaw

Located In: Corner Code #

1. Public Land Survey	T 12 N. R 4 E.	A-5
	T _____ R _____	_____
	T _____ R _____	_____
	T _____ R _____	_____
2. Property Controlling in Section	S _____ T _____ R _____	_____
	S _____ T _____ R _____	_____
3. Miscellaneous Property in Sec.	S _____ T _____ R _____	_____
	S _____ T _____ R _____	_____

JAN 3 3 23 PM '94

REGISTER OF DEEDS
SAGINAW COUNTY MICH.

Liber 6 page 193

Register of Deeds Stamp & File Number

4. Lot No. _____, Recorded Plat _____
5. Private Claims _____

	A	B	C	D	E	F	G	H	I	J	K	L	M
2	6		5		4		3		2		1		
3													
4	7		8		9		10		11		12		
5													
6	18		17		16		15		14		13		
7													
8	19		20		21		22		23		24		
9													
10	30		29		28		27		26		25		
11													
12	31		32		33		34		35		36		
13													

I, Ronald C. Prevost, in a field survey on December, 19 93, do hereby certify that under requirements of P.A. 74, Michigan P.A. of 1970, the corner points mentioned in lines 1 and 2 above were in conformance with regulations and rules therefore as required in the current manual of survey instructions of the United States Department of the Interior, Bureau of Land Management or by a decree of a Court of Law and/or that the corner points mentioned in lines 3, 4 and 5 above were in conformance with the rules of the Michigan Board of Land Surveyors or by a Decree of a Court of Law; established, re-established, monumented, re-monumented, recovered, found as expressed below:

NOTE: Not more than 4 corners, all in the same town and range, may be recorded on this certificate.

A. Description of original monument and accessories and/or subsequent restoration:

- A-5 Post Set By J. Wampler, 1822
Beech 9 NE 14 Links
Beech 8 NW 8 Links
- A-5 3/4" Iron Recorded Liber 4, Pg. 73, 1977
SE 45.00 Ctr. Hyd.
NE 36.42 Ctr. M.H. Cover
SW 38.08 Face P. & T. Pole


B. Description of corner evidence found and/or method applied in restoring or reestablishing corner:

- A-5 Found 3/4" Iron Bar 5" below bit., as per Liber 4, Pg. 73, and is accepted as the best available evidence of the position of the original corner.
- Ratified by Saginaw County Peer Review Group 12-22-93

NOTE: Corner A-5 of T.12 N.-R.4 E. has been used as a common corner with M-5 of T.12 N.-R.3 E., since about 1925 even though A-5 could be 13.2 feet South of M-5.

C. Description of monument for corner and accessories established to perpetuate locating the position of the corner:

- A-5 Set 5/8" x 18" Re-bar with Saginaw Co. Re-mon Bronze Cap Stamped #24612 & Mon. Box.
Ctr. M.H. Cover N.70°E. 36.42
Nail & Cap NW Face P. & T. Pole S.60°E. 57.54
Hyd. S.65°E. 66.81
Nail & Cap S. Face P. & T. Pole S.45°W. 37.90
Nail & Cap NE Face P. & T. Pole N.60°W. 66.52

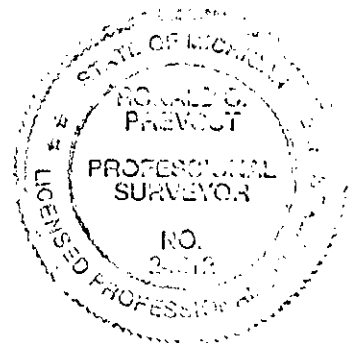

Signed by Ronald C. Prevost
24612

Date 12-30-93

Surveyor's Michigan License No. _____