

1993

LAND CORNER RECORDATION CERTIFICATE

Filing Requirement of Act 74, Mich. P.A. 1970

RECORDED & FILED

For corners in COMMISSION

Saginaw

(County)

Located In:

Corner Code #

- 1. Public Land Survey T 12 N. R 4 E. A-6
T _____ R _____
T _____ R _____
T _____ R _____
- 2. Property Controlling S _____ T _____ R _____
in Section S _____ T _____ R _____
- 3. Miscellaneous S _____ T _____ R _____
Property in Sec. S _____ T _____ R _____

Jan 3 3 23 PM '94

REGISTER OF DEEDS SAGINAW COUNTY MICH.

Lib 6 Page 192 Register of Deeds Stamp & File Number

- 4. Lot No. _____, Recorded Plat _____
- 5. Private Claims _____

	A	B	C	D	E	F	G	H	I	J	K	L	M
2	6		5		4		3		2		1		
3													
4	7		8		9		10		11		12		
5													
6	18		17		16		15		14		13		
7													
8	19		20		21		22		23		24		
9													
10	30		29		28		27		26		25		
11													
12	31		32		33		34		35		36		
13													

I, Ronald C. Prevost, in a field survey on December, 19 93, do hereby certify that under requirements of P.A. 74, Michigan P.A. of 1970, the corner points mentioned in lines 1 and 2 above were in conformance with regulations and rules therefore as required in the current manual of survey instructions of the United States Department of the Interior, Bureau of Land Management or by a decree of a Court of Law and/or that the corner points mentioned in lines 3, 4 and 5 above were in conformance with the rules of the Michigan Board of Land Surveyors or by a Decree of a Court of Law; established, re-established, monumented, re-monumented, recovered, found as expressed below:

NOTE: Not more than 4 corners, all in the same town and range, may be recorded on this certificate.

A. Description of original monument and accessories and/or subsequent restoration:

A-6 Corner Not Set in Original Survey.


B. Description of corner evidence found and/or method applied in restoring or reestablishing corner:

A-6 Found 1/2" Rod in Mon. Box and is accepted as the best available evidence of the position of the corner.

Ratified by Saginaw County Peer Review Group 12-22-93

C. Description of monument for corner and accessories established to perpetuate locating the position of the corner:

- A-6 Set 5/8" x 18" Re-bar with Saginaw Co. Re-mon Bronze Cap Stamped #24612 in existing Mon. Box
Ctr. M.H. Cover N.05°E. 66.47
Hyd. S.85°E. 51.13
Cross in Conc. Pvt. S.0°E. 32.14
Nail & Cap S. Face Light Pole N.15°W. 70.94

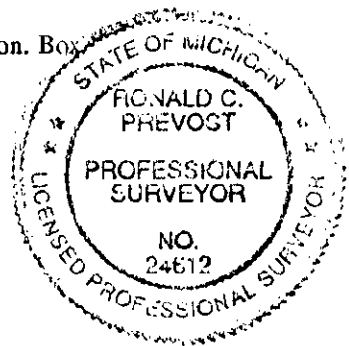

Signed by Ronald C. Prevost

Date 12-30-93

Surveyor's Michigan License No. 24612