

**SURVEY & REMONUMENTATION**

LIBER 1882 PAGE 1679

NOV 12 1993

*Liber 6 page 133*

**COMMISSION**

**LAND CORNER RECORDATION CERTIFICATE**  
Filing Requirement of Act 74, Mich. P.A. 1970

For corners in  
Saginaw

(County)

Located In:

Corner Code -##

	12N	4E	A-9
1. Public Land Survey	T _____ R _____	T _____ R _____	_____
	T _____ R _____	T _____ R _____	_____
	T _____ R _____	T _____ R _____	_____
2. Property Controlling in Section	S _____ T _____ R _____	S _____ T _____ R _____	_____
	S _____ T _____ R _____	S _____ T _____ R _____	_____
3. Miscellaneous Property in Sec.	S _____ T _____ R _____	S _____ T _____ R _____	_____
	S _____ T _____ R _____	S _____ T _____ R _____	_____

NOV 3 12 32 PM '93  
MILBURN H. DODAK  
REGISTERED DEEDS  
SAGINAW COUNTY MICH.

RECORDED & FILED

Register of Deeds Stamp & File Number

4. Lot No. \_\_\_\_\_, Recorded Plat \_\_\_\_\_  
5. Private Claims \_\_\_\_\_

	A	B	C	D	E	F	G	H	I	J	K	L	M
2	6	5	4	3	2	1							
3													
4	7	8	9	10	11	12							
5													
6	18	17	16	15	14	13							
7													
8	19	20	21	22	23	24							
9													
10	30	29	28	27	26	25							
11													
12	31	32	33	34	35	36							
13													

I, John H. Rauser, in a field survey on October, 1993, do hereby certify that under requirements of P.A. 74, Michigan P.A. of 1970, the corner points mentioned in lines 1 and 2 above were in conformance with regulations and rules therefore as required in the current manual of survey instructions of the United States Department of the Interior, Bureau of Land Management or by a decree of a Court of Law and/or that the corner points mentioned in lines 3, 4 and 5 above were in conformance with the rules of the Michigan Board of Land Surveyors or by a Decree of a Court of Law; established, re-established, monumented, re-monumented, recovered, found as expressed below:

**NOTE: Not more than 4 corners, all in the same town and range, may be recorded on this certificate.**

**A. Description of original monument and accessories and/or subsequent restoration:**

A-9 Closing cor., Sec. 19 & 20, T12N-R4E

Wood post placed by J. Wampler, 1822  
3 lks. (1.98') South of Standard cor. Sec. 24 & 25, T12N-R3E  
N80 E 5 lks. (3.30') 13" Beech  
S30 E 22 lks. (14.52') 20" Pine

No record of subsequent restoration

**B. Description of corner evidence found and/or method applied in restoring or reestablishing corner:**

A-9 Closing cor., Sec. 19 & 20, T12N-R4E

Fnd. no evidence of original government corner. Fnd. 3/4" pipe in monument box. This corner has been improperly utilized through the years as a common corner with (A-9) Closing cor., Sec. 19 & 30, T12N-R4E. As shown in recorded survey & LCRC in 1982 by Beryl M. Jones recorded in L. 1610, pg. 2142 & L. 1720, pg. 888 in which the corner was recorded as A-9. In recorded LCRC's 1979 by Donald Hammond, L. 4, pg. 223 & 1982 by Duane F. Ledy, L. 6, pg. 43 the corner was recorded as M-9 showing the same witnesses as Beryl Jones. On a survey by CP Co. drawing #S-F16228, the corner is shown as a common corner. Therefore the closing corner (A-9) was established at a position by GLO call of 3 lks. South of M-9, T12N-R3E, holding the corner found as M-9, and set on line between M-9 & M-10 of T12N-R3E and is accepted as the best available evidence of the position of the original cor.

Approved by Saginaw County Peer Review September 30, 1993


**C. Description of monument for corner and accessories established to perpetuate locating the position of the corner:**

A-9 Closing cor., Sec. 19 & 20, T12N-R4E

Set 5/8" rerod w/brass cap stamped Saginaw County Monument P.S. #39096 in drill hole of old conc. surface under asphalt overlay and placed monument box at corner.  
North 1.98' (3 lks.) Standard corner, Sec. 24 & 25, T12N-R3E  
S52°E 35.63' Set chis "+" in W. rim manhole  
N85°E 38.14' Fnd. Nail & Tag in N face Tri-Walnut  
N80°W 30.29' Set PK w/tag #12018 in N face Power Pole  
S88°E 55.95' Set PK w/tag #12018 in S face Power Pole  
N30°W 71.65' Set chis. "+" in SE cor., of metal rim of H<sub>2</sub>O manhole pit.

Signed by John H. Rauser Date 11/03/93

Surveyor's Michigan License No. 39096

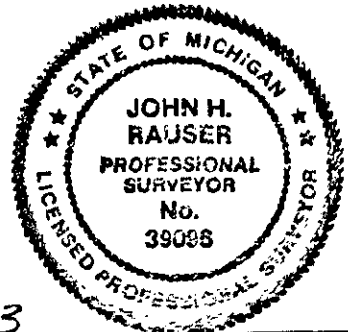

*11/18/93*