

SAGINAW COUNTY REMONUMENTATION

DEC 15 1993

LAND CORNER RECORDATION CERTIFICATE
Filing Requirement of Act 74, Mich. P.A. 1970

Nov 24 2 02 PM '93

INDEXED
RECORDED
SAGINAW COUNTY MICH.

Liber 6 Page 144

COMMISSION
For corners in
Saginaw
(County)

Located In: Corner Code #

- | | | |
|---------------------------------------|-------------------------|-------|
| 1. Public Land Survey | T 12 N. R 4 E. | B-1 |
| | T _____ R _____ | _____ |
| | T _____ R _____ | _____ |
| | T _____ R _____ | _____ |
| 2. Property Controlling in Section | S _____ T _____ R _____ | _____ |
| | S _____ T _____ R _____ | _____ |
| 3. Miscellaneous Property in Sec. | S _____ T _____ R _____ | _____ |
| | S _____ T _____ R _____ | _____ |
| 4. Lot No. _____, Recorded Plat _____ | | |
| 5. Private Claims _____ | | |

Register of Deeds Stamp & File Number

I, Ronald C. Prevost, in a field survey on Oct./Nov., 19 93, do hereby certify that under requirements of P.A. 74, Michigan P.A. of 1970, the corner points mentioned in lines 1 and 2 above were in conformance with regulations and rules therefore as required in the current manual of survey instructions of the United States Department of the Interior, Bureau of Land Management or by a decree of a Court of Law and/or that the corner points mentioned in lines 3, 4 and 5 above were in conformance with the rules of the Michigan Board of Land Surveyors or by a Decree of a Court of Law; established, re-established, monumented, re-monumented, recovered, found as expressed below:

NOTE: Not more than 4 corners, all in the same town and range, may be recorded on this certificate.

	A	B	C	D	E	F	G	H	I	J	K	L	M
2	6	5	4	3	2	1							
3													
4	7	8	9	10	11	12							
5													
6	18	17	16	15	14	13							
7													
8	19	20	21	22	23	24							
9													
10	30	29	28	27	26	25							
11													
12	31	32	33	34	35	36							
13													

A. Description of original monument and accessories and/or subsequent restoration:

- B-1 **Corner Not Set in Original Survey.**
Corner B-13 was set by J. Wampler in 1822, while running the S. Boundary of T.13 N.-R.4 E., and has been used and accepted as a common corner for B-1.
3/4" Pipe Found by Spicer Engineering Crew 3 1/2" below bituminous in 1971, raised with 3/4".
SE 45.2' Spike in N. Face 36" Elm Stump 4.7' N. of centerline bit. surf.
3/4" Pipe Recorded Liber 4, Pg. 234 & shown on Recorded Survey Liber 1760, Pg. 1885
S.4.7' to centerline bit. surface E. & W.1
S.33.00 3/4" Pipe w/cap #4699
N.60°W., 135.3' Nail & Cap S. Face P. Pole


B. Description of corner evidence found and/or method applied in restoring or reestablishing corner:

- B-1 Found 3/4" Pipe in Mon. box, as per Liber 4, Pg. 234, and is accepted as the best available evidence of the position of the original corner.

Ratified by Saginaw County Peer Review Group 10/07/93

C. Description of monument for corner and accessories established to perpetuate locating the position of the corner:

- B-1 Set 5/8" x 18" Re-bar with Saginaw Co. Re-Mon Bronze Cap Stamped #24612 in place of 3/4" pipe and in existing Mon. Box.
- | | | |
|--|---------|--------|
| Nail & Cap, N. Face Power Pole | S.80°E. | 163.80 |
| 3/4" Pipe South | | 33.00 |
| Centerline of Bituminous Surface South | | 4.7' |
| Nail & Cap, N. Face Power Pole | S.80°W. | 189.31 |
| Nail & Cap, S. Face Power Pole | N.70°W. | 132.28 |

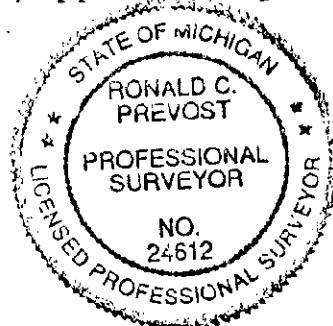

Signed by Ronald C. Prevost

Date 11-24-93

Surveyor's Michigan License No. 24612