SURVEY & REMONUMENTATION

LIBER 1887 PAGE 1018

SAGINAW COUNTY REMONUMENTATION

DEC 15 1993

LAND CORNER RECORDATION CERTIFICATE

Filing Requirement of Act 74, Mich. P.A. 1970

RECORDED & FILED COMMISSION

For corners in Saginaw (County)

	Located In:	Corner Code ##
1. Public Land Survey	T 12 N. R 4 E.	B-3
	T ___ R ___	
	T ___ R ___	
	T ___ R ___	
2. Property Controlling	S ___ T ___ R ___	
in Section	S ___ T ___ R ___	
3. Miscellaneous	S ___ T ___ R ___	
Property in Sec.	S ___ T ___ R ___	

DEC 9 4 27 PM '93

MILDRED A. DUCAN
REGISTER OF DEEDS
SAGINAW COUNTY MICH.

Liber 6 Page 163

Register of Deeds Stamp & File Number

4. Lot No. _____ , Recorded Plat _____
5. *Private Claims* _____

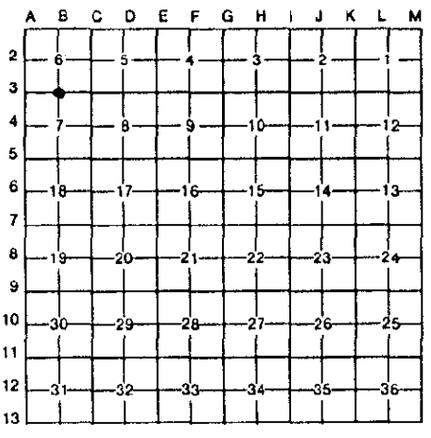

I, Ronald C. Prevost , in a field survey on Oct./Dec. , 19 93 , do hereby certify that under requirements of P.A. 74, Michigan P.A. of 1970, the corner points mentioned in lines 1 and 2 above were in conformance with regulations and rules therefore as required in the current manual of survey instructions of the United States Department of the Interior, Bureau of Land Management or by a decree of a Court of Law and/or that the corner points mentioned in lines 3, 4 and 5 above were in conformance with the rules of the Michigan Board of Land Surveyors or by a Decree of a Court of Law; established, re-established, monumented, re-monumented, recovered, found as expressed below:

NOTE: Not more than 4 corners, all in the same town and range, may be recorded on this certificate.

A. Description of original monument and accessories and/or subsequent restoration:

B-3 Post Set by J. Wampler in 1822.
B-3 Co. Surveyor H. Cary, 1879, Old Witnesses Remaining.
B-3 1/2" Iron Bar Recorded Liber 2, Pg. 161, 1973
B-3 RR Spike Recorded Liber 5, Pg. 14, 1979.

B. Description of corner evidence found and/or method applied in restoring or reestablishing corner:

B-3 Found RR Spike at Bit. Surface (agrees with above recordings) and is accepted as the best available evidence of the position of the original corner.

Ratified by Saginaw County Peer Review Group 9-23-93

C. Description of monument for corner and accessories established to perpetuate locating the position of the corner:

B-3 Set 5/8" x 18" Re-bar with Saginaw Co. Re-Mon Bronze Cap Stamped #24612 and Mon. Box.

Nail & Cap in E. Face 10" American Elm	N.0°E.	141.20
Nail & Cap in N. Face 24" American Elm	S.5°E.	45.02
Face Conc. Light Pole	N.70°W.	96.00
S.W. Corner Foundation Att'd Garage	N.45°W.	119.05
Ctr. Hyd.	S.80°E.	138.36

STATE OF MICHIGAN
RONALD C. PREVOST
PROFESSIONAL SURVEYOR
NO. 24612
LICENSED PROFESSIONAL SURVEYOR

Signed by Ronald C. Prevost Date 12-9-93

Surveyor's Michigan License No. 24612

FORM APPROVED BY MICHIGAN STATE BOARD OF LAND SURVEYORS. JAN. 28, 1971
REVISED MAY 14, 1975
REVISED JAN., 1983