

LAND CORNER RECORDATION CERTIFICATE  
Filing Requirement of Act 74, Mich. P.A. 1970

DEC 15 1993

For corners in  
Saginaw  
(County)

Located In: Corner Code -##

1. Public Land Survey	T12 N. R 4 E.	B-5
	T _____ R _____	_____
	T _____ R _____	_____
	T _____ R _____	_____
2. Property Controlling in Section	S _____ T _____ R _____	_____
	S _____ T _____ R _____	_____
3. Miscellaneous Property in Sec.	S _____ T _____ R _____	_____
	S _____ T _____ R _____	_____

RECORDED COMMISSION

DEC 9 4 27 PM '93

MICHAEL J. GODAR  
REGISTER OF DEEDS  
SAGINAW COUNTY MICH.

*Liber 164*  
Register of Deeds Stamp & File Number

4. Lot No. \_\_\_\_\_, Recorded Plat \_\_\_\_\_  
5. Private Claims \_\_\_\_\_

I, Ronald C. Prevost, in a field survey on Oct./Dec., 19 93, do hereby certify that under requirements of P.A. 74, Michigan P.A. of 1970, the corner points mentioned in lines 1 and 2 above were in conformance with regulations and rules therefore as required in the current manual of survey instructions of the United States Department of the Interior, Bureau of Land Management or by a decree of a Court of Law and/or that the corner points mentioned in lines 3, 4 and 5 above were in conformance with the rules of the Michigan Board of Land Surveyors or by a Decree of a Court of Law; established, re-established, monumented, re-monumented, recovered, found as expressed below:

A	B	C	D	E	F	G	H	I	J	K	L	M
2	6	5	4	3	2	1						
3												
4	7	8	9	10	11	12						
5												
6	18	17	16	15	14	13						
7												
8	19	20	21	22	23	24						
9												
10	30	29	28	27	26	25						
11												
12	31	32	33	34	35	36						
13												

NOTE: Not more than 4 corners, all in the same town and range, may be recorded on this certificate.

A. Description of original monument and accessories and/or subsequent restoration:

B-5 Post Set by J. Wampler in 1822.  
Co. Surveyor H. Cary, 1879, 1/4 Common Sections 7 & 18  
Stake 50 L N.  
Fence Post 49 1/2 L S.  
Sag. Co. Rd. Comm. - 2 Witness Cards  
2 Recorded Surveys, Liber 1456, Pg. 744 and Liber 1683, Pg. 877


B. Description of corner evidence found and/or method applied in restoring or reestablishing corner:

B-5 Found 3/4" Pipe, appears to agree with Road Comm. & Rec'd Surveys, and is accepted as the best available evidence of the position of the original corner.

Ratified by Saginaw County Peer Review Group 9-23-93

C. Description of monument for corner and accessories established to perpetuate locating the position of the corner:

B-5	Set 5/8" x 18" Re-bar with Saginaw Co. Re-Mon Bronze Cap Stamped #24612 and Mon. Box. in place of 3/4"		
	Ctr. Catchbasin Cover	N. 2°E.	28.12
	Nail & Cap N. Face 10" White Ash	N.60°E.	83.06
	NE Cor. Foundation House	S.45°E.	131.26
	Nail & Cap W. Face P. & T. Pole	S. 0°E.	46.50
	Ctr. Hyd.	S.30°W.	33.95

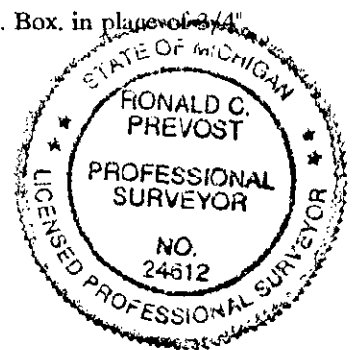

Signed by Ronald C. Prevost

Date 12-9-93

Surveyor's Michigan License No. 24612