

DEC 15 1993

LAND CORNER RECORDATION CERTIFICATE Filing Requirement of Act 74, Mich. P.A. 1970

Nov 24 2 02 PM '93

COMMISSION For corners in Saginaw (County)

WILBUR LODAK REGISTER OF DEEDS SAGINAW COUNTY MICH.

Libor 6 Page 146

Table with 3 columns: Item, Located In, Corner Code. Includes Public Land Survey, Property Controlling, and Miscellaneous Property in Sec.

Register of Deeds Stamp & File Number

4. Lot No. , Recorded Plat Private Claims

Grid table with columns A-M and rows 1-13, containing numbers 1-36.

I, Ronald C. Prevost, in a field survey on Oct/Nov, 1993, do hereby certify that under requirements of P.A. 74, Michigan P.A. of 1970, the corner points mentioned in lines 1 and 2 above were in conformance with regulations and rules therefore as required in the current manual of survey instructions of the United States Department of the Interior, Bureau of Land Management or by a decree of a Court of Law and/or that the corner points mentioned in lines 3, 4 and 5 above were in conformance with the rules of the Michigan Board of Land Surveyors or by a Decree of a Court of Law; established, re-established, monumented, re-monumented, recovered, found as expressed below:

NOTE: Not more than 4 corners, all in the same town and range, may be recorded on this certificate.

A. Description of original monument and accessories and/or subsequent restoration:


- C-1 Post Set by J. Wampler in 1822. (Intersection Bndry. at Post) 3/4" Pipe Found By Spicer Engineering, 1951, 8" Below Bit. C-1 1" Iron Bar Found By Sag. Co. Rd. Comm., 1973. Includes bearings and distances for various monuments.

B. Description of corner evidence found and/or method applied in restoring or reestablishing corner:

- C-1 Found 1/2" Boat Spike in Mon. Box per Liber 2, Pg. 247, and is accepted as a careful and faithful perpetuation of the position of the original corner. Ratified by Saginaw County Peer Review Group 9-23-93

C. Description of monument for corner and accessories established to perpetuate locating the position of the corner:

- C-1 Set 5/8" x 18" Re-bar with Saginaw Co. Re-Mon Bronze Cap Stamped #24612 in place of Boat Spike. Ctr. Hydrant, Nail & Cap in Face T. Pole, NE Cor. R.R. Flasher Base, USGS Monument. Includes bearings and distances.

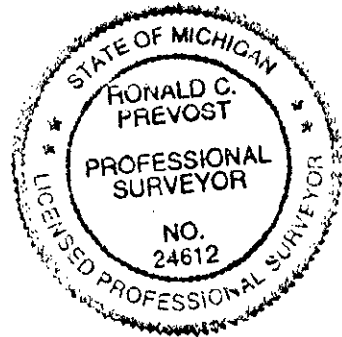

Signed by [Signature] Date 11-24-93 Surveyor's Michigan License No. 24612