

SAGINAW COUNTY REMONUMENTATION

LIBER 1887 PAGE 1020

LAND CORNER RECORDATION CERTIFICATE
Filing Requirement of Act 74, Mich. P.A. 1970

RECORDED & FILED

For corners in
Saginaw
(County)

Located In: Corner Code #

- 1. Public Land Survey T 12 NR 4 E. C-2
T _____ R _____
T _____ R _____
T _____ R _____
- 2. Property Controlling S _____ T _____ R _____
in Section S _____ T _____ R _____
- 3. Miscellaneous S _____ T _____ R _____
Property in Sec. S _____ T _____ R _____
- 4. Lot No. _____, Recorded Plat _____
- 5. Private Claims _____

DEC 9 4 27 PM '93

HILDEN L. DODAK
REGISTER OF DEEDS
SAGINAW COUNTY MICH.

Liber 6 Page 165
Register of Deeds Stamp & File Number

A	B	C	D	E	F	G	H	I	J	K	L	M
2	6	5	4	3	2	1						
3												
4	7	8	9	10	11	12						
5												
6	18	17	16	15	14	13						
7												
8	19	20	21	22	23	24						
9												
10	30	29	28	27	26	25						
11												
12	31	32	33	34	35	36						
13												

I, Ronald C. Prevost, in a field survey on Oct./Dec., 19 93, do hereby certify that under requirements of P.A. 74, Michigan P.A. of 1970, the corner points mentioned in lines 1 and 2 above were in conformance with regulations and rules therefore as required in the current manual of survey instructions of the United States Department of the Interior, Bureau of Land Management or by a decree of a Court of Law and/or that the corner points mentioned in lines 3, 4 and 5 above were in conformance with the rules of the Michigan Board of Land Surveyors or by a Decree of a Court of Law; established, re-established, monumented, re-monumented, recovered, found as expressed below:

NOTE: Not more than 4 corners, all in the same town and range, may be recorded on this certificate.

A. Description of original monument and accessories and/or subsequent restoration:

C-2 Post Set by J. Wampler in 1822.
Co. Surveyor H. Cary, 1879, Stone Buried in Road
RR Spike Recorded Liber 2, Pg. 247, 1974
SW^{ly} 162.38 to Ctr. Hyd.
NW 125.83 to Face T. Pole
E 28.5 to Face Square Fence Post

3/4" Pipe Rec'd Liber 4, Pg. 234, 1979,
to perpetuate RR Spike location
SW 162.53 Ctr. Hyd.
NE 38.03 4" Gasline Marker
SW 57.03 Face T. Pole
Rec'd Surveys Liber 1578, Pg. 2122 & Liber 1760, Pg. 1885 indicate same location.

B. Description of corner evidence found and/or method applied in restoring or reestablishing corner:

C-2 Found 3/4" Pipe as per Liber 4, Pg. 234, and is accepted as the best available evidence of the position of the original corner.

Ratified by Saginaw County Peer Review Group 9-30-93

SURVEY &
REMONUMENTATION


1993

COMMISSION

C. Description of monument for corner and accessories established to perpetuate locating the position of the corner:

C-2 Set 5/8" x 18" Re-bar with Saginaw Co. Re-Mon Bronze Cap Stamped #24612 and Mon. Box

Nail & Cap W. Face P. & T. Pole	N.20°E.	132.05
Ctr. 2" Gate Post	East	60.44
Nail & Cap W. Face P. & T. Pole	S.20°E.	200.30
Ctr. Hyd.	S.10°W.	162.48
Nail & Cap E. Face T. Pole	N.10°W.	125.78

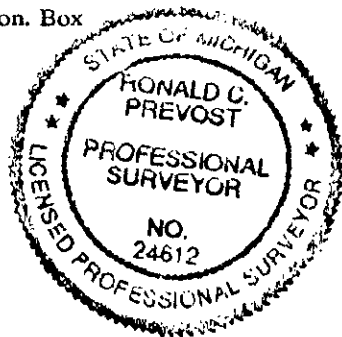

Signed by Ronald C. Prevost

Date 12-9-93

Surveyor's Michigan License No. 24612