

1993

LAND CORNER RECORDATION CERTIFICATE
Filing Requirement of Act 74, Mich. P.A. 1970

COMMISSION
RECORDED & FILED

For corners in

Saginaw
(County)

Located In:

Corner Code #


- | | | | | |
|------------------------------------|---|-------|------|-------|
| | | 12 N. | 4 E. | C-5 |
| 1. Public Land Survey | T | _____ | R | _____ |
| | T | _____ | R | _____ |
| | T | _____ | R | _____ |
| | T | _____ | R | _____ |
| 2. Property Controlling in Section | S | _____ | T | _____ |
| | S | _____ | T | _____ |
| 3. Miscellaneous Property in Sec. | S | _____ | T | _____ |
| | S | _____ | T | _____ |
4. Lot No. _____, Recorded Plat _____
5. Private Claims _____

Dec 9 4 27 PM '93

MICHAEL J. BUDAK
REGISTER OF DEEDS
SAGINAW COUNTY MICH.

Liber 6 Page 166
Register of Deeds Stamp & File Number

I, Ronald C. Prevost, in a field survey on Oct./Dec., 19 93, do hereby certify that under requirements of P.A. 74, Michigan P.A. of 1970, the corner points mentioned in lines 1 and 2 above were in conformance with regulations and rules therefore as required in the current manual of survey instructions of the United States Department of the Interior, Bureau of Land Management or by a decree of a Court of Law and/or that the corner points mentioned in lines 3, 4 and 5 above were in conformance with the rules of the Michigan Board of Land Surveyors or by a Decree of a Court of Law; established, re-established, monumented, re-monumented, recovered, found as expressed below:

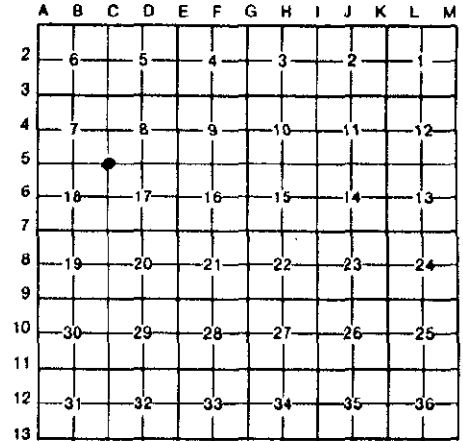

NOTE: Not more than 4 corners, all in the same town and range, may be recorded on this certificate.

A. Description of original monument and accessories and/or subsequent restoration:

- C-5 Post Set by J. Wampler in 1822.
- C-5 Co. Surveyor H. Cary, 1878, Stone buried in road.
- C-5 Co. Surveyor H. Cary, 1879, Stone buried in road.
- C-5 Nail Recorded Liber 1, Pg. 252, 1972.
- C-5 Nail Shown & Used in Recorded Surveys Liber 1361, Pg. 1067, Liber 1643, Pg. 1165, & Liber 1683, Pg. 877.
- C-5 3/4" Pipe Found by S.C.R.C. Crew 1993, S.60°E. Face P.P. 108.05
S.50°W. Face P.P. 59.0
N.50°W. Face L.P. 49.05
N.45°W. Face Fire Hyd. 45.06


B. Description of corner evidence found and/or method applied in restoring or reestablishing corner:

- C-5 Found 3/4" Pipe @ Bit. Surface (agrees with the above), and is accepted as the best available evidence of the position of the original corner.

Ratified by Saginaw County Peer Review Group 9-30-93

C. Description of monument for corner and accessories established to perpetuate locating the position of the corner:

- C-5 Set 5/8" x 18" Re-bar with Saginaw Co. Re-Mon Bronze Cap Stamped #24612 & Mon. Box.
- X-Cut on SW 1/4 Rim Manhole N.50°E. 26.75
- Nail & Cap in N. Face P. & T. Pole S.75°E. 108.63
- Nail & Cap in N. Face P. & T. Pole S.65°W. 59.13
- Ctr. Hyd. N.45°W. 45.58
- Nail & Cap S. Face Light Pole N.50°W. 49.23

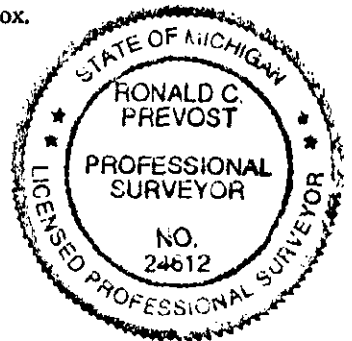

Ronald C. Prevost

Signed by _____ 24612

Date 12-9-93

Surveyor's Michigan License No. _____