

SAGINAW COUNTY REMONUMENTATION

LAND CORNER RECORDATION CERTIFICATE
Filing Requirement of Act 74, Mich. P.A. 1970

For corners in Saginaw (County)

Located In: Corner Code #

- 1. Public Land Survey T 12 N. R 4 E. D-5
2. Property Controlling in Section S T R
3. Miscellaneous Property in Sec. S T R

RECORDED & FILED

DEC 9 4 27 PM '93

MICHIGAN REGISTER OF DEEDS SAGINAW COUNTY MICH.

Liber 6 Page 169 Register of Deeds Stamp & File Number

- 4. Lot No. , Recorded Plat
5. Private Claims

Grid table with columns A-M and rows 2-13. A dot is marked at row 5, column C.

I, Ronald C. Prevost, in a field survey on Oct./Dec. 19 93, do hereby certify that under requirements of P.A. 74, Michigan P.A. of 1970, the corner points mentioned in lines 1 and 2 above were in conformance with regulations and rules therefore as required in the current manual of survey instructions of the United States Department of the Interior, Bureau of Land Management or by a decree of a Court of Law and/or that the corner points mentioned in lines 3, 4 and 5 above were in conformance with the rules of the Michigan Board of Land Surveyors or by a Decree of a Court of Law; established, re-established, monumented, re-monumented, recovered, found as expressed below:

NOTE: Not more than 4 corners, all in the same town and range, may be recorded on this certificate.

A. Description of original monument and accessories and/or subsequent restoration:

- D-5 Post Set by J. Wampler in 1822.
D-5 Co. Surveyor H. Cary, 1878, Stone Buried in Road.
D-5 3/4" Iron Pipe by Redmond 1939
S.10.0 to Centerline Bit. Surface
NE 14" Maple 43.35
SE 18" Elm 85.9
S. 6°W. 14" Maple 27.6
D-5 3/4" Pipe Recorded Set from Recorded Plat ties
Allenhurst Commons & Woodcrest Park L. 4, Pg. 73
South 32.20 Nail & Cap E. Side P. Pole
N.50°E. 42.70 Ctr. Hyd.
N.50°W. 45.60 Ctr. St. Sign Post
N.50°E. 46.35 Nail & Cap NE Side 15" Catalpa
D-5 S.C.R.C. Witnesses 1993 & Recorded
Survey Liber 1761, Pg. 768

B. Description of corner evidence found and/or method applied in restoring or reestablishing corner:

- D-5 Found 3/4" Pipe (agrees with S.C.R.C. 1993, Rec. Survey, L 1761, P 768 & Rec. Cor. L 4, P 73), and is accepted as the best available evidence of the position of the original corner.

Ratified by Saginaw County Peer Review Group 9-30-93


SURVEY & REMONUMENTATION

1993

COMMISSION

C. Description of monument for corner and accessories established to perpetuate locating the position of the corner:

- D-5 Set 5/8" x 18" Re-bar with Saginaw Co. Re-Mon Bronze Cap Stamped #24612 and Mon. Box.
Nail & Cap in SW Face 30" W. Pine N.45°E. 79.49
Ctr. Hyd. N.50°E. 42.71
Nail & Cap NE Face 30" Catalpa S.70°E. 46.39
Nail & Cap W Face Light Pole S. 0°E 32.17
Nail & Cap E Face 20" Sugar Maple 72.79

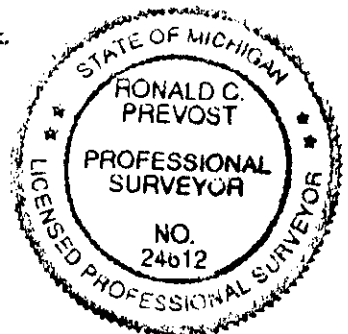

Signed by Ronald C. Prevost

Date 12-9-93

Surveyor's Michigan License No. 24612