

**SURVEY & REMONUMENTATION**

LIBER 1882 PAGE 1671

*Liber 6 Page 125*

NOV 12 1993

**LAND CORNER RECORDATION CERTIFICATE**  
Filing Requirement of Act 74, Mich. P.A. 1970

M. DREW DODAK  
REGISTER OF DEEDS,  
SAGINAW COUNTY, MICH.

Nov 3 12 32 PM '93

RECORDED & FILED

For corners in  
Saginaw

**COMMISSION**

	Located In:		Corner Code ##
	12N	4E	
1. Public Land Survey	T _____	R _____	D-9
	T _____	R _____	
	T _____	R _____	
	T _____	R _____	
2. Property Controlling in Section	S _____	T _____	R _____
	S _____	T _____	R _____
3. Miscellaneous Property in Sec.	S _____	T _____	R _____
	S _____	T _____	R _____

Register of Deeds Stamp & File Number

4. Lot No. \_\_\_\_\_, Recorded Plat \_\_\_\_\_  
5. Private Claims \_\_\_\_\_

	A	B	C	D	E	F	G	H	I	J	K	L	M
2	6	5	4	3	2	1							
3													
4	7	8	9	10	11	12							
5													
6	18	17	16	15	14	13							
7													
8	19	20	21	22	23	24							
9		•											
10	30	29	28	27	26	25							
11													
12	31	32	33	34	35	36							
13													

I, John H. Rauser, in a field survey on September, 1993, do hereby certify that under requirements of P.A. 74, Michigan P.A. of 1970, the corner points mentioned in lines 1 and 2 above were in conformance with regulations and rules therefore as required in the current manual of survey instructions of the United States Department of the Interior, Bureau of Land Management or by a decree of a Court of Law and/or that the corner points mentioned in lines 3, 4 and 5 above were in conformance with the rules of the Michigan Board of Land Surveyors or by a Decree of a Court of Law; established, re-established, monumented, re-monumented, recovered, found as expressed below.

**NOTE: Not more than 4 corners, all in the same town and range, may be recorded on this certificate.**

**A. Description of original monument and accessories and/or subsequent restoration:**

D-9 1/4 cor., Sec. 20 & 29, T12N-R4E

Wood post placed by J. Wampler D.S. in 1822  
S01°W 15 lks. (9.9') 9" Ironwood  
N46°W 27 lks. (17.82') 16" Beech

1878 survey by H. Cary, County Surveyor  
Fnd. post county survey Record No. 42, pg. 90 & 91  
S08°E 96 lks. (63.36') 30" S. Maple  
S39°E 48 lks. (31.68') 18" Elm

1958 recorded plats of Allen Park "B" & "C"  
L. 11, pg. 22 & L. 11, pg. 48, S.C.R.

1959 recorded plat of Allen Park "D"  
L. 12, pg. 39, S.C.R.

1979 LCRC by Ronald C. Prevost recorded in L. 4, pg. 202  
Fnd. 3/4" pipe  
N45°W 68.28' SE cor. brick house  
N10°E 32.66' CL steel fence post  
N80°E 151.34' Face Power Pole

**B. Description of corner evidence found and/or method applied in restoring or reestablishing corner:**

D-9 1/4 cor., Sec. 20 & 29, T12N-R4E


Fnd. 3/4" pipe in monument box per LCRC  
L. 4, pg. 202  
Fnd. no evidence of original government corner.

Approved by Saginaw County Peer Review September 23, 1993

**C. Description of monument for corner and accessories established to perpetuate locating the position of the corner:**

D-9 1/4 cor., Sec. 20 & 29, T12N-R4E

Re-set 5/8" re-rod w/brass cap stamped Saginaw County Monument P.S. #39096 in centerline of Siedel Street and is accepted as the best available evidence of the position of the original corner.  
N45°W 68.25' (R = 68.28') SE cor. brick house  
N10°E 32.65' (R = 32.66') Centerline E face steel fence post  
N80°E 151.95' PK w/tag #12018 N face Power Pole (R = 151.34' to face of power pole)  
S46°W 109.47' NW cor. brick house #5515 1'± above grade

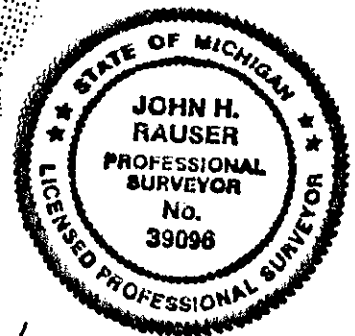

Signed by John H. Rauser  
Surveyor's Michigan License No. 39096

Date 11/03/93

*11/8/93*