

LAND CORNER RECORDATION CERTIFICATE

FILING REQUIREMENT OF ACT 74, MICH. P.A. 1970

1993

COMMISSION

FOR CORNERS OF--	LOCATED IN--	CORNER CODE NUMBER
1. PUBLIC LAND SURVEY	T. 12 N. S., R. 4 E. W.	D-13
2. PROPERTY CONTROLLING IN SECTION	T. _____ N. S., R. _____ E. W.	_____
3. MISCELLANEOUS PROPERTY IN SECTION	T. _____ N. S., R. _____ E. W.	_____
4. LOT NO. _____, RECORDED PLAT _____		
5. PRIVATE CLAIMS _____		

RECORDED & FILED
Liber 6 page 181
 DEC 22 2 13 PM '93
 H. J. BOONAK
 REGISTER OF DEEDS
 SAGINAW COUNTY MICH.
 REGISTER OF DEEDS STAMP AND FILING NUMBER

I, Duane F. Ledy, do hereby certify that under requirements of P.A. 74, Michigan P.A. of 1970, the corner points mentioned in lines 1 and 2 above were, in a field survey on September, 1993, established, re-established, monumented, re-monumented, recovered or restored as expressed below and in conformance with regulations and rules therefore as required in the current manual of survey instructions of the United States Department of the Interior, Bureau of Land Management or by a decree of a court of law. Furthermore, that the corner points mentioned in lines 3, 4 and 5 above were, in a field survey on September, 1993, found, recovered, restored, established or re-established as expressed below and in conformance with the rules of the Michigan State Board of Registration for Land Surveyors or, by a Decree of a Court of law:


A. Description of original monument and accessories and/or subsequent restoration:
 Wood post set in 1822 by Wampler at 40.00 chains. No records of original monument or any subsequent restoration or perpetuation of corner.

B. Description of corner evidence found and/or method applied in restoring or re-establishing corner:
 Set corner on line between D-1 and E-1 at mid distance between C-13 and E-13. Corner position ratified by Saginaw County Remonumentation Peer Group Review on November 3, 1993.

C. Description of monument for corner and accessories established to perpetuate locating the position of the corner:
 Set 5/8" rod and Sag. Co. Remon. 3" brass cap.

West	11.25	3/4" pipe; corner D-1, T11N, R4E
S 10 E	100.11	Nail and brass tag marked "P.S. 21575" in W. side 24" Maple
S 05 W	72.70	Nail and brass tag marked "P.S. 21575" in W. side 30" Cottonwood
S 40 W	73.17	Nail and brass tag marked "P.S. 21575" in W. side 26" Willow
N 80 W	48.96	Nail and brass tag marked "P.S. 21575" in S. side 6" Ash

SIGNED BY Duane F. Ledy DATE Dec. 22 1993
 SURVEYOR'S MICHIGAN REGISTRATION NO. 21575
 FOR STATE AND UNITED STATES AGENCIES:
 SIGNED BY _____ DATE _____
CHIEF OF SURVEY PARTY
 APPROVED AND SIGNED BY _____ DATE _____
MICHIGAN REGISTERED LAND SURVEYOR

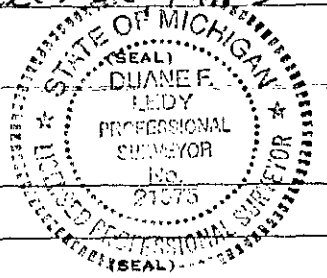

SURVEYOR'S MICHIGAN REGISTRATION NO. _____