

SURVEY & REMONUMENTATION

NOV 1 2 1993

LIBER 1882 PAGE 1677

Liber 6 page 131

SURVEY & REMONUMENTATION

LAND CORNER RECORDATION CERTIFICATE

Filing Requirement of Act 74, Mich. P.A. 1970

For corners in Saginaw (County)

NOV 1 2 1993

COMMISSION

Located In:

Corner Code #

	12N	4E	E-7
1. Public Land Survey	T	R	
	T	R	
	T	R	
	T	R	
2. Property Controlling in Section	S	T	R
	S	T	R
3. Miscellaneous Property in Sec.	S	T	R
	S	T	R

MILITARY LODGE REGISTER OF DEEDS SAGINAW COUNTY MICH.


NOV 3 12 32 PM '93

RECORDED & FILED

Register of Deeds Stamp & File Number

4. Lot No. _____, Recorded Plat _____
 5. Private Claims _____

I, John H. Rauser, in a field survey on October, 1993, do hereby certify that under requirements of P.A. 74, Michigan P.A. of 1970, the corner points mentioned in lines 1 and 2 above were in conformance with regulations and rules therefore as required in the current manual of survey instructions of the United States Department of the Interior, Bureau of Land Management or by a decree of a Court of Law and/or that the corner points mentioned in lines 3, 4 and 5 above were in conformance with the rules of the Michigan Board of Land Surveyors or by a Decree of a Court of Law; established, re-established, monumented, re-monumented, recovered, found as expressed below:

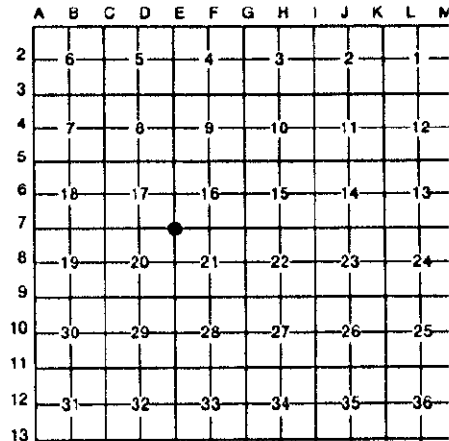

NOTE: Not more than 4 corners, all in the same town and range, may be recorded on this certificate.

A. Description of original monument and accessories and/or subsequent restoration:

E-7 Sec. cor., 16, 17, 20 & 21, T12N-R4E

Wood post placed by J. Wampler, D.S. 1822
 East 11 lks. (7.26') 44" Pine
 N49°W 23 lks. (15.18') 40" Pine

1983 Act 132 survey by Brian D. Ferguson
 L. 1620, pg. 1434, S.C.R.

1946 unrecorded witnesses from Spicer Eng.
 NW 49.2' SE face Power Pole
 NW 71.0' SE face 16" Elm
 NE 45.1' SW face Power Pole
 SW 53.0' NE face 16" Elm
 SE 95.0' NW cor. new brick building

1985 LCRC by Grant J. Ward, L. 1665, pg. 830, S.C.R.

1981 LCRC by Ronald C. Prevost, L. 3, pg. 165, S.C.R.

B. Description of corner evidence found and/or method applied in restoring or reestablishing corner:

E-7 Sec. cor., 16, 17, 20 & 21, T12N-R4E

Found 3/4" iron pipe in broken mon. box as per recorded witnesses and Spicer Eng. field notes.

Found no evidence of original government corner.


Approved by Saginaw County Peer Review September 23, 1993

C. Description of monument for corner and accessories established to perpetuate locating the position of the corner:

E-7 Sec. cor., 16, 17, 20 & 21, T12N-R4E

Re-set 5/8" re-rod w/brass cap stamped Saginaw County Monument, P.S. #39096 at centerline - centerline of M-58 and Center, raised monument box to surface and is accepted as the best available evidence of the position or the original corner.

S45W 64.62' (R = 64.50') Centerline fire hydrant
 N35 W 63.41' (R & M) PK w/tag #22445 in SW face util. pole
 N40 E 61.17' (R = 61.10') PK w/tag #22445 in SE face util. pole
 N55 E 86.99' (R = 86.84') Centerline fire hydrant
 S37 E 95.11' (R = 95') NW cor. brick "Westwood Party Shoppe" bldg.

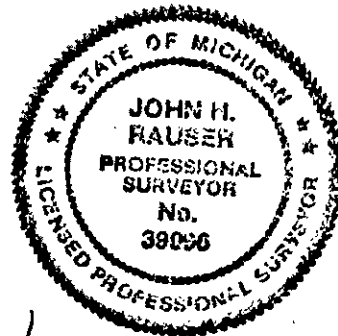

Signed by John H. Rauser Date 11/03/93
 Surveyor's Michigan License No. 39096

11/18/93