

SURVEY & REMONUMENTATION LIBER 1889 PAGE 215
REMONUMENTATION CORNER RECORDATION CERTIFICATE

1993 FILING REQUIREMENT OF ACT 74, MICH. P.A. 1970

COMMISSION FOR CORNERS OF--	LOCATED IN--	CORNER CODE NUMBER
1. PUBLIC LAND SURVEY	T. <u>12</u> N. S., R. <u>4</u> E. W.	E-13
2. PROPERTY CONTROLLING IN SECTION	, T. _____ N. S., R. _____ E. W.	
3. MISCELLANEOUS PROPERTY IN SECTION	, T. _____ N. S., R. _____ E. W.	
4. LOT NO. _____, RECORDED PLAT _____		
5. PRIVATE CLAIMS _____		

RECORDED & FILED
Lib 6 page 18E
 Dec 22 2 13 PM '93
 HILL & BOUAK
 REGISTER OF DEEDS
 SAGINAW COUNTY MICH.
 REGISTER OF DEEDS STAMP AND FILING NUMBER

I, Duane F. Ledy, do hereby certify that under requirements of P.A. 74, Michigan P.A. of 1970, the corner points mentioned in lines 1 and 2 above were, in a field survey on September, 1993, established, re-established, monumented, re-monumented, recovered or restored as expressed below and in conformance with regulations and rules therefore as required in the current manual of survey instructions of the United States Department of the Interior, Bureau of Land Management or by a decree of a court of law. Furthermore, that the corner points mentioned in lines 3, 4 and 5 above were, in a field survey on September, 1993, found, recovered, restored, established or re-established as expressed below and in conformance with the rules of the Michigan State Board of Registration for Land Surveyors or, by a Decree of a Court of law:


A. Description of original monument and accessories and/or subsequent restoration:
 No corner set by Wampler in 1822 during GLO survey. Post set on section line between 32 and 33 at 2.50 chains North of corner E-13. GLO survey by Wampler of T11N, R4E states E-1 to close 50 links West of E-13. Existing E-1 referenced in bridge plans and L.C.R.C. L3, P175 recorded in 1976.

B. Description of corner evidence found and/or method applied in restoring or re-establishing corner:
 Found chisled "X" at E-1. Established E-13 at 11.02' East, per recorded witnesses. Position ratified by Saginaw County Remonumentation Peer Group Review on October 15, 1993.

C. Description of monument for corner and accessories established to perpetuate locating the position of the corner:

- Set 3" brass Sag. Co. Remon. cap in bridge floor.
- West 1.5' construction centerline
- N 45 W 27.23 Brass tag marked "P.S. 21575" on top conc. bridge rail
- N 45 E 26.36 Brass tag marked "P.S. 21575" on top conc. bridge rail
- S 45 W 26.43 Brass tag marked "P.S. 21575" on top conc. bridge rail
- S 85 E 17.10 Brass tag marked "P.S. 21575" on top conc. bridge rail

SIGNED BY Duane F. Ledy DATE Dec 22 1993
 SURVEYOR'S MICHIGAN REGISTRATION NO. 21575
 FOR STATE AND UNITED STATES AGENCIES:
 SIGNED BY _____ DATE _____
CHIEF OF SURVEY PARTY
 APPROVED AND SIGNED BY _____ DATE _____
MICHIGAN REGISTERED LAND SURVEYOR (SEAL)

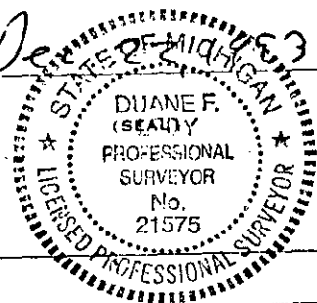

SURVEYOR'S MICHIGAN REGISTRATION NO. _____