

SURVEY & REMONUMENTATION

LIBER 1882 PAGE 1663

NOV 12 1993

Liber 6 Page 117

LAND CORNER RECORDATION CERTIFICATE
Filing Requirement of Act 74, Mich. P.A. 1970

COMMISSION

For corners in
Saginaw

(County)

Located In:

Corner Code #

	12N	4E	F-9
1. Public Land Survey	T	R	
	T	R	
	T	R	
	T	R	
2. Property Controlling in Section	S	T	R
	S	T	R
3. Miscellaneous Property in Sec.	S	T	R
	S	T	R

HILDAE L. UODAK
REGISTER OF DEEDS
SAGINAW COUNTY MICH.

NOV 3 12 30 PM '93

RECORDED & FILED

Register of Deeds Stamp & File Number

4. Lot No. _____, Recorded Plat _____
5. Private Claims _____

	A	B	C	D	E	F	G	H	I	J	K	L	M
2	6	5	4	3	2	1							
3													
4	7	8	9	10	11	12							
5													
6	18	17	16	15	14	13							
7													
8	19	20	21	22	23	24							
9													
10	30	29	28	27	26	25							
11													
12	31	32	33	34	35	36							
13													

I, John H. Rauser in a field survey on October, 1993, do hereby certify that under requirements of P.A. 74, Michigan P.A. of 1970, the corner points mentioned in lines 1 and 2 above were in conformance with regulations and rules therefore as required in the current manual of survey instructions of the United States Department of the Interior, Bureau of Land Management or by a decree of a Court of Law and/or that the corner points mentioned in lines 3, 4 and 5 above were in conformance with the rules of the Michigan Board of Land Surveyors or by a Decree of a Court of Law; established, re-established, monumented, re-monumented, recovered, found as expressed below:

NOTE: Not more than 4 corners, all in the same town and range, may be recorded on this certificate.

A. Description of original monument and accessories and/or subsequent restoration:

F-9 1/4 cor., Sec. 21 & 28, T12N-R4E

Wood post placed by J. Wampler, D.S. 1822
S03°W 12 lks. (7.92') 11" Birch
N19°E 10 lks. (6.60') 34" Lynnwood
1952 Brentwood, L. 7, pg. 12 & 13, S.C.R.
1953 Brockway Center Subdivision
L. 4, pg. 43, S.C.R.

1956 Golfview Subdivision, L. 10,
pg. 14, S.C.R.
1956 Fleetwood Subdivision, L. 10,
pg. 23, S.C.R.
1972 Act 132 survey & LCRC by
Gerald R. McKelvey recorded in L. 1364,
pg. 216 & 217, & L. 1, pg. 182, S.C.R.

B. Description of corner evidence found and/or method applied in restoring or reestablishing corner:

F-9 1/4 cor., Sec. 21 & 28, T12N-R4E


Fnd. 1" pipe laying flat with remains of wood post, rock & stones, old pieces of conc. and spikes.
Re-established position of corner from existing plat monumentation of the recorded plat of Fleetwood Subdivision recorded in L. 10, pg. 23, S.C.R. This position as established fell within recovered evidence area and fit witnesses as recorded in LCRC L. 1, pg. 216 & 217, S.C.R. Found no evidence of original government corner.

Approved by Saginaw County Peer Review September 23, 1993

C. Description of monument for corner and accessories established to perpetuate locating the position of the corner:

F-9 1/4 cor., Sec. 21 & 28, T12N-R4E

Set 5/8" re-rod w/brass cap stamped Saginaw County Monument P.S. #39096 in the centerline - centerline of Hemmeter Road & Siedel Road and is accepted as the best available evidence of the position of the original corner.
North 11.76' = R & M Center of manhole
N55°E 55.46' (R = 55.56') Top center fire hydrant
N35°E 45.09' Set PK w/tag #12018 in WNW face Power Pole
S37°W 54.08' Fnd. conc. monument
S46°W 121.94' NE cor. of living area of house #4515
1'± above grade
S37°E 54.58' Fnd. 3/4" pipe

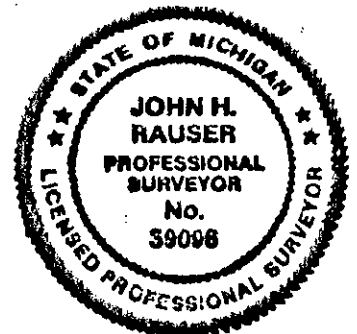

Signed by John H. Rauser Date 11/03/93
Surveyor's Michigan License No. 39096

11/18/93