

SURVEY & REMONUMENTATION

LIBER 1882 PAGE 1666

Liber 6 Page 120

NOV 12 1993

COMMISSION

LAND CORNER RECORDATION CERTIFICATE
Filing Requirement of Act 74, Mich. P.A. 1970

For corners in
Saginaw

Located in:

Corner Code #

	12N	4E	G-9
1. Public Land Survey	T _____ R _____	T _____ R _____	_____
	T _____ R _____	T _____ R _____	_____
	T _____ R _____	T _____ R _____	_____
2. Property Controlling in Section	S _____ T _____ R _____	S _____ T _____ R _____	_____
	S _____ T _____ R _____	S _____ T _____ R _____	_____
3. Miscellaneous Property in Sec.	S _____ T _____ R _____	S _____ T _____ R _____	_____
	S _____ T _____ R _____	S _____ T _____ R _____	_____


HILGREN, J. JOONAK
 REGISTER OF DEEDS,
 SAGINAW COUNTY MICH.

NOV 3 12 32 PM '93

RECORDED & FILED

Register of Deeds Stamp & File Number

4. Lot No. _____, Recorded Plat _____
 5. Private Claims _____

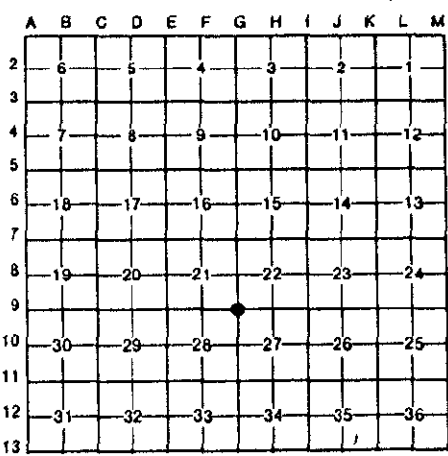

I, John H. Rauser, in a field survey on October, 1993, do hereby certify that under requirements of P.A. 74, Michigan P.A. of 1970, the corner points mentioned in lines 1 and 2 above were in conformance with regulations and rules therefore as required in the current manual of survey instructions of the United States Department of the Interior, Bureau of Land Management or by a decree of a Court of Law and/or that the corner points mentioned in lines 3, 4 and 5 above were in conformance with the rules of the Michigan Board of Land Surveyors or by a Decree of a Court of Law; established, re-established, monumented, re-monumented, recovered, found as expressed below:

NOTE: Not more than 4 corners, all in the same town and range, may be recorded on this certificate.

A. Description of original monument and accessories and/or subsequent restoration:

G-9 Sec. cor., 21, 22, 27 & 28, T12N-R4E

Wood post placed by J. Wampler, D.S. 1822 S18°W 23 lks. (15.18') 8" Beech N09°W 18 lks. (11.88') 7" Beech	1946 Lathrup Park Sub. No. 2, L. 6, pg. 8, of plats, S.C.R.
1938 Count survey by County Surveyor Redmond pg. 28, S.C.R.	1950's unrecorded City of Saginaw Resurvey Map #60 & #77.

B. Description of corner evidence found and/or method applied in restoring or reestablishing corner:

G-9 Sec. cor., 21, 22, 27 & 28, T12N-R4E

Found 3/4" iron pipe in asphalt road surface as per recorded plat, County Survey record and City of Saginaw resurvey.

Found no evidence of original government corner.


Approved by Saginaw County Peer Review September 23, 1993

C. Description of monument for corner and accessories established to perpetuate locating the position of the corner:

G-9 Sec. cor., 21, 22, 27 & 28, T12N-R4E

Re-set 5/8" re-rod w/brass cap stamped Saginaw County Monument, P.S. #39096 in monument box at the centerline - centerline of Passolt & Brockway Street, and is accepted as the best available evidence of the position of the orig. cor.

N25°W 79.80' Set PK w/tag #12018 in utility pole
 East 48.28' Set PK w/tag #12018 in utility pole
 N42°E 85.71' SW cor. brick house #902 Passolt 1'± above grade
 N84°W 90.94' Set spike w/tag #12018 in SW face 8" Mountain Ash

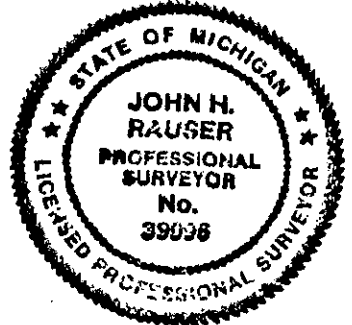

Signed by John H. Rauser
 Surveyor's Michigan License No. 39096

Date 11/03/93

11/18/93