

REMONUMENTATION CORNER RECORDATION CERTIFICATE

1993 FILING REQUIREMENT OF ACT 74, MICH. P.A. 1970

COMMISSION FOR CORNERS OF --:	LOCATED IN --:	CORNER CODE NUMBER
1. PUBLIC LAND SURVEY _____ T. <u>12</u> N. S., R. <u>4</u> E. W.		G-10
2. PROPERTY CONTROLLING IN SECTION _____, T. _____ N. S., R. _____ E. W.		
3. MISCELLANEOUS PROPERTY IN SECTION _____, T. _____ N. S., R. _____ E. W.		
4. LOT NO. _____, RECORDED PLAT _____		
5. PRIVATE CLAIMS _____		

RECORDED & FILED
Liber 6 page 187
 DEC 22 2 14 PM '93
 HILLMAN & BARKER
 REGISTER OF DEEDS
 SAGINAW COUNTY MICH.
 REGISTER OF DEEDS STAMP AND FILING NUMBER

I, DUANE F. LEDY, do hereby certify that under requirements of P.A. 74, Michigan P.A. of 1970, the corner points mentioned in lines 1 and 2 above were, in a field survey on SEPTEMBER, 1993, established, re-established, monumented, re-monumented, recovered or restored as expressed below and in conformance with regulations and rules therefore as required in the current manual of survey instructions of the United States Department of the Interior, Bureau of Land Management or by a decree of a court of law. Furthermore, that the corner points mentioned in lines 3, 4 and 5 above were, in a field survey on SEPTEMBER, 1993, found, recovered, restored, established or re-established as expressed below and in conformance with the rules of the Michigan State Board of Registration for Land Surveyors or, by a Decree of a Court of law:

A. Description of original monument and accessories and/or subsequent restoration:

Wood post set in 1822 by Wampler at 40.00 chains.
 No records available of date or method of placement of existing monument at G-10.

B. Description of corner evidence found and/or method applied in restoring or re-establishing corner:

Found axle shaft in monument box. Existing corner referenced in 1917, City of Saginaw, Surveys, no witnesses.
 Measurements agree with City of Saginaw Resurveys.
 Corner witnessed in L.C.R.C. Liber 6, page 44, recorded in 1978. Corner ratified by Saginaw County Remonumentation Peer Group Review on September 30, 1993.

C. Description of monument for corner and accessories established to perpetuate locating the position of the corner:

Set 5/8" Rod & Sag. Co. Remon. 3" Brass Cap
 N 15 W 28.08 Nail & brass tag marked "PS 21575" in E. side G.P.
 N 75 E 131.10 Nail & brass tag marked "PS 21575" in S. side G.P.
 S 70 E 90.54 Nail & brass tag marked "PS 21575" in N. side P.P.
 S 15 W 26.33 Nail & brass tag marked "PS 21575" in E. side P.P.
 S 55 W 98.22 Nail & brass tag marked "PS 21575" in N. side P.P.


SIGNED BY Duane F. Ledy DATE Dec. 22 1993

SURVEYOR'S MICHIGAN REGISTRATION NO. 21575

FOR STATE AND UNITED STATES AGENCIES:

SIGNED BY _____ DATE _____
CHIEF OF SURVEY PARTY

APPROVED AND SIGNED BY _____ DATE _____
MICHIGAN REGISTERED LAND SURVEYOR

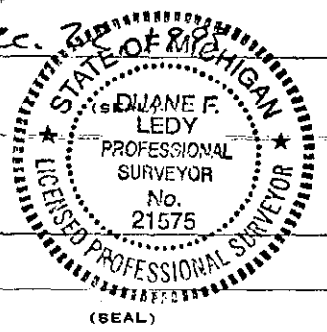

SURVEYOR'S MICHIGAN REGISTRATION NO. _____