

APPROVED BY PEER GROUP
P.A. 345 OF 1990
SAGINAW COUNTY

8-20-96

SAGINAW COUNTY REMONUMENTATION

LAND CORNER RECORDATION CERTIFICATE
Filing Requirement of Act 74, Mich. P.A. 1970

Liber 7 Page 69

For corners in


<u>Saginaw</u> (County)	Located in: City of Saginaw	Corner Code #
1. Public Land Survey	T <u>12N</u> R <u>4E</u>	<u>H-7</u>
	T _____ R _____	_____
2. Property Controlling in Section	S _____ T _____ R _____	_____
	S _____ T _____ R _____	_____
3. Miscellaneous Property in Sec.	S _____ T _____ R _____	_____
	S _____ T _____ R _____	_____

REGISTERED & FILED
 SEP 27 11 42 AM 1996
 HILDRED H. DODAK
 REGISTER OF DEEDS
 SAGINAW COUNTY MICH.
 Register of Deeds Stamp & File Number

- 4. Lot No. _____, Recorded Plat _____
- 5. Private Claims _____

I, Brian D Ferguson, in a field survey on September 3, 1996 do hereby state that under requirements of P.A. 74, Michigan P.A. of 1970, the corner points mentioned in lines 1 and 2 above were in conformance with regulations and rules therefore as required in the current manual of survey instructions of the United States Department of the Interior, Bureau of Land Management or by a decree of a Court of Law and/or that the corner points mentioned in lines 3, 4 and 5 above were in conformance with the rules of the Michigan Board of Land Surveyors or by a Decree of a Court of Law; established, re-established, monumented, recovered, found as expressed below:

NOTE: Not more than 2 corners, all in the same town and range, may be recorded on this certificate.

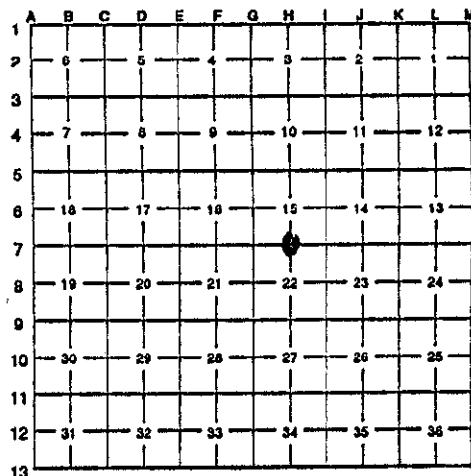

A. Description of original monument and accessories and/or subsequent restoration:


H-7 Wood post set by Wampler, 1822.
 Plat L. 5, Pg. 26
 No recorded LCRC's.

B. Description of corner evidence found and/or method applied in restoring or reestablishing corner:

H-7 Found 2" city marker 3" below asphalt surface.
 Position agrees with plat L.5, pg. 26, City of Saginaw re-survey maps.
 Accepted by peer group as best available evidence of original corner.

C. Description of monument for corner and accessories established to perpetuate locating the position of the corner:

H-7 Set 5/8" steel bar with Saginaw County Remon. cap in monument box.
 N0°E 20.05 Spike E face guy pole.
 N60°W 54.75 Spike NE face 28" elm.
 S2°E 24.12 Spike W face light pole.
 S20°W 64.60 NE corner house foundation (No. 3153 State).

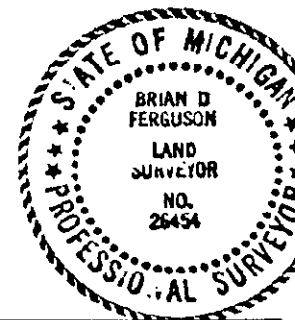

Signed by Brian D Ferguson
 Surveyor's Michigan License No. 26454

Date 9-27-96

REMONU

MAY 1 8 1997

CON