

NOV 12 1993

Liber 6 Page 137

COMMISSION

LAND CORNER RECORDATION CERTIFICATE  
Filing Requirement of Act 74, Mich. P.A. 1970

RECORDED & FILED

For corners in  
Saginaw  
(County)

Located In: Corner Code #:

- 1. Public Land Survey T 12N R 4E 1-4  
T 12N R 4E 1-5  
T \_\_\_\_\_ R \_\_\_\_\_  
T \_\_\_\_\_ R \_\_\_\_\_
- 2. Property Controlling in Section S \_\_\_\_\_ T \_\_\_\_\_ R \_\_\_\_\_  
S \_\_\_\_\_ T \_\_\_\_\_ R \_\_\_\_\_
- 3. Miscellaneous Property in Sec. S \_\_\_\_\_ T \_\_\_\_\_ R \_\_\_\_\_  
S \_\_\_\_\_ T \_\_\_\_\_ R \_\_\_\_\_
- 4. Lot No. \_\_\_\_\_, Recorded Plat \_\_\_\_\_
- 5. Private Claims \_\_\_\_\_

Nov 5 9 11 AM '93

HENRI J. DUDAK  
REGISTER OF DEEDS  
SAGINAW COUNTY MICH.

Register of Deeds Stamp & File Number

I, Brian D Ferguson, in a field survey on September 30, 19 93, do hereby certify that under requirements of P.A. 74, Michigan P.A. of 1970, the corner points mentioned in lines 1 and 2 above were in conformance with regulations and rules therefore as required in the current manual of survey instructions of the United States Department of the Interior, Bureau of Land Management or by a decree of a Court of Law and/or that the corner points mentioned in lines 3, 4 and 5 above were in conformance with the rules of the Michigan Board of Land Surveyors or by a Decree of a Court of Law; established, re-established, monumented, re-monumented, recovered, found as expressed below:

A	B	C	D	E	F	G	H	I	J	K	L	M
2	6	5	4	3	2	1						
3												
4	7	8	9	10	11	12						
5												
6	18	17	16	15	14	13						
7												
8	19	20	21	22	23	24						
9												
10	30	29	28	27	26	25						
11												
12	31	32	33	34	35	36						
13												

NOTE: Not more than 4 corners, all in the same town and range, may be recorded on this certificate.

A. Description of original monument and accessories and/or subsequent restoration:

I-4 Wood Post set by J. Wampler in 1822. No evidence of original post exists.

I-5 Wood Post set by J. Wampler in 1822. No evidence of original post exists.

B. Description of corner evidence found and/or method applied in restoring or reestablishing corner:

I-4 Found 3/4" rod in monument box. Previous LCRC'S in L 1 Pg 266, L 1 Pg 252 and L 4 Pg 153. Two recorded surveys tie to this corner and is accepted as the best available evidence of the position of the original corner. Accepted by the Peer Review Group on 10/07/93


I-5 Found 1/2" rod in monument box. Previous LCRC's recorded in L 1 Pg 264 and L 1 Pg 252. Two recorded surveys are tied to this corner and is accepted as the best available evidence of the position of the original corner. Accepted by the Peer Review Group on 10/07/93

C. Description of monument for corner and accessories established to perpetuate locating the position of the corner:

I-4 3" Brass Disk in monument box  
N40°W 55.73' Top ctr hydrant  
N75°W 61.99' Nail & Tag S fce pwr pole  
S70°E 42.18' PK nail/ ref disk S fce pwr pole  
N60°E 45.72' Chisled + top ctr curb @ S. line of asphalt filled island @ S. line of U-Haul prop

I-5 3" Brass Disk in monument box  
N45°W 72.55' Nail & tag E fce guy pole  
N45°E 79.13' Top ctr hydrant  
S45°E 61.34' Nail & tag W fce guy pole  
S45°W 60.91' Nail & tage E fce guy pole

Signed by Brian D Ferguson Date 10-28-93  
Surveyor's Michigan License No. 26454

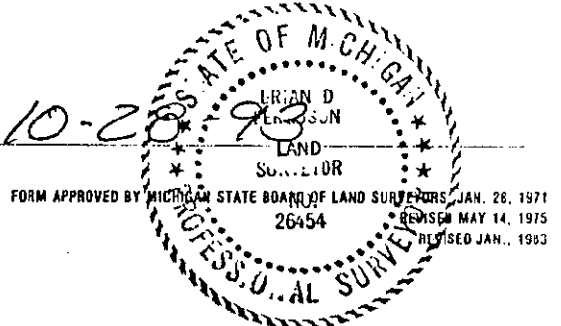

11/18/93