

SAGINAW COUNTY REMONUMENTATION

LAND CORNER RECORDATION CERTIFICATE
Filing Requirement of Act 74, Mich. P.A. 1970

For corners in

Saginaw Located in: City of Saginaw, Corner Code #
(County) Saginaw Township

1. Public Land Survey T 12N R 4E 1-6
T _____ R _____

2. Property Controlling S _____ T _____ R _____
in Section S _____ T _____ R _____

3. Miscellaneous S _____ T _____ R _____
Property in Sec. S _____ T _____ R _____

4. Lot No. _____, Recorded Plat _____

5. Private Claims _____

Liber 7 Page 73

REGISTERED & FILED
MILDRED H. DODAK
REGISTER OF DEEDS
SAGINAW COUNTY MICHIGAN
SEP 27 11 42 AM 1996
Register of Deeds Stamp & File Number

I, Brian D Ferguson, in a field survey on September 3, 1996 do hereby state that under requirements of P.A. 74, Michigan P.A. of 1970, the corner points mentioned in lines 1 and 2 above were in conformance with regulations and rules therefore as required in the current manual of survey instructions of the United States Department of the Interior, Bureau of Land Management or by a decree of a Court of Law and/or that the corner points mentioned in lines 3, 4 and 5 above were in conformance with the rules of the Michigan Board of Land Surveyors or by a Decree of a Court of Law; established, re-established, monumented, recovered, found as expressed below:

NOTE: Not more than 2 corners, all in the same town and range, may be recorded on this certificate.

1	A	B	C	D	E	F	G	H	I	J	K	L	M
2		6		5		4		3		2			
3													
4		7		8		9		10		11		12	
5													
6		18		17		16		15		14		13	
7													
8		19		20		21		22		23		24	
9													
10		30		29		28		27		26		25	
11													
12		31		32		33		34		35		36	
13													

A. Description of original monument and accessories and/or subsequent restoration:

I-6 Wood post set by Wampler, 1822.
LCRC L. 1, Pg. 252; L.1, Pg. 263.
Surveys L. 1555, Pg. 975; L 1571, Pg. 230; L. 1603, Pg. 348; L. 1739, Pg. 1877.
Plats L. 8, Pg. 43; L. 14, Pg. 47.

B. Description of corner evidence found and/or method applied in restoring or reestablishing corner:


I-6 Found 2" city marker in monument box.
Position agrees with City of Saginaw re-survey map.
Accepted by peer group as best available evidence of original corner.

C. Description of monument for corner and accessories established to perpetuate locating the position of the corner:

I-6 Epoxy Saginaw County Remon. cap to 2" city marker in monument box.
N45°W 66.20 SE corner concrete pad.
S50°W 66.79 N & S NW face power / light pole.
S40°W 87.12 N & S W face power pole.
N45°E 54.00 N & S SE face power / light pole.

Signed by Brian D Ferguson
Surveyor's Michigan License No. 26454

Date 9-27-96

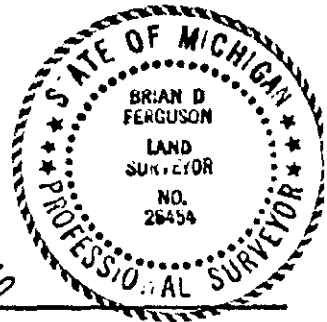

SURVEY &
REMONUMENTATION

MAY 16 1997