

DEC 15 1993

LIBER 1887 PAGE 630

Liber 6 Page 157

LAND CORNER RECORDATION CERTIFICATE  
Filing Requirement of Act 74, Mich. P.A. 1970

RECORDED  
Filed

DEC 8 3 30 PM '93

MILDRED L. DODAK  
REGISTER OF DEEDS  
SAGINAW COUNTY MICH.

For corners in

Saginaw

(County)

Located In:

Corner Code -#

1. Public Land Survey	T 12N R 4E	K-3
	T 12N R 4E	K-4
	T _____ R _____	_____
	T _____ R _____	_____
2. Property Controlling in Section	S _____ T _____ R _____	_____
	S _____ T _____ R _____	_____
3. Miscellaneous Property in Sec.	S _____ T _____ R _____	_____
	S _____ T _____ R _____	_____

Register of Deeds Stamp & File Number

- 4. Lot No. \_\_\_\_\_, Recorded Plat \_\_\_\_\_
- 5. Private Claims \_\_\_\_\_

	A	B	C	D	E	F	G	H	I	J	K	L	M
2	6	5	4	3	2	1							
3													
4	7	8	9	10	11	12							
5													
6	18	17	16	15	14	13							
7													
8	19	20	21	22	23	24							
9													
10	30	29	28	27	26	25							
11													
12	31	32	33	34	35	36							
13													

I, Brian D Ferguson, in a field survey on September 30, 19 93, do hereby certify that under requirements of P.A. 74, Michigan P.A. of 1970, the corner points mentioned in lines 1 and 2 above were in conformance with regulations and rules therefore as required in the current manual of survey instructions of the United States Department of the Interior, Bureau of Land Management or by a decree of a Court of Law and/or that the corner points mentioned in lines 3, 4 and 5 above were in conformance with the rules of the Michigan Board of Land Surveyors or by a Decree of a Court of Law; established, re-established, monumented, re-monumented, recovered, found as expressed below:

NOTE: Not more than 4 corners, all in the same town and range, may be recorded on this certificate.

A. Description of original monument and accessories and/or subsequent restoration:

K-3 Wood post set by J. Wampler in 1822. No evidence of original post exists.

K-4 Wood post set by J. Wampler in 1822. No evidence of original post exists.

B. Description of corner evidence found and/or method applied in restoring or reestablishing corner:

K-3 Set at NW Corner of Skyhaven Park No. 4 from information obtained from existing conc monuments, property irons and information obtained from MDOT and is accepted as the best available evidence of the position of the original corner. Accepted by the Peer Review Group on 11/12/93

K-4 Set at SW Corner of Oak View Subdivision from information obtained from existing conc monuments, property irons and information obtained from MDOT and is accepted as the best available evidence of the position of the original corner. Accepted by the Peer Review Group on 11/12/93

C. Description of monument for corner and accessories established to perpetuate locating the position of the corner:

K-3 3" Brass Disk in monument box


K-4 3" Brass Disk in monument box

North 17'± Ctr line Universal Drain  
N85°E 72.45' Top ctr 10" CMP  
S80°E 16.29' "+" Top ctr 48" RCP  
S89°W 41.30' "+" SE cor S'ly wingwall  
N63°W 50.48' "+" NE cor headwall

N70°E 68.80' SW cor block fndn hse #3515  
East 99.06' Nail in W fce 18" Oak  
S70°E 69.52' NW Cor block fndn hse #3505  
West 3.51' MDOT r/w fence

Signed by Brian D Ferguson  
Surveyor's Michigan License No. 26454

Date \_\_\_\_\_

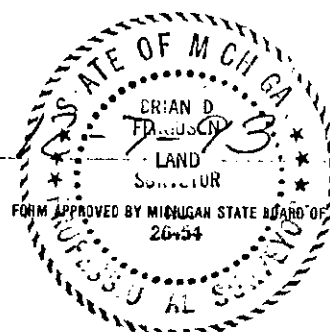

FORM APPROVED BY MICHIGAN STATE BOARD OF LAND SURVEYORS, JAN. 28, 1971  
REVISED MAY 14, 1975  
REVISED JAN., 1983