

SURVEY & REMONUMENTATION

LIBER 1883 PAGE 32

Lib 6 Page 13

NOV 12 1993

COMMISSION

LAND CORNER RECORDATION CERTIFICATE
Filing Requirement of Act 74, Mich. P.A. 1970

RECORDED & FILED

For corners in

Saginaw

(County)

Located In:

Corner Code #

- | | | |
|---------------------------------------|--------------------------|------------|
| 1. Public Land Survey | T <u>12N</u> R <u>4E</u> | <u>L-3</u> |
| | T <u>12N</u> R <u>4E</u> | <u>L-5</u> |
| | T _____ R _____ | _____ |
| | T _____ R _____ | _____ |
| 2. Property Controlling in Section | S _____ T _____ R _____ | _____ |
| | S _____ T _____ R _____ | _____ |
| 3. Miscellaneous Property in Sec. | S _____ T _____ R _____ | _____ |
| | S _____ T _____ R _____ | _____ |
| 4. Lot No. _____, Recorded Plat _____ | | |
| 5. Private Claims _____ | | |

Nov 5 9 11 AM '93

MILDRED A. DODAR
REGISTER OF DEEDS
SAGINAW COUNTY MICH.

Register of Deeds Stamp & File Number

I, Brian D Ferguson, in a field survey on September 30, 19 93

do hereby certify that under requirements of P.A. 74, Michigan P.A. of 1970, the corner points mentioned in lines 1 and 2 above were in conformance with regulations and rules therefore as required in the current manual of survey instructions of the United States Department of the Interior, Bureau of Land Management or by a decree of a Court of Law and/or that the corner points mentioned in lines 3, 4 and 5 above were in conformance with the rules of the Michigan Board of Land Surveyors or by a Decree of a Court of Law; established, re-established, monumented, re-monumented, recovered, found as expressed below:

NOTE: Not more than 4 corners, all in the same town and range, may be recorded on this certificate.

	A	B	C	D	E	F	G	H	I	J	K	L	M
2	6	5	4	3	2	1							
3													
4	7	8	9	10	11	12							
5													
6	18	17	16	15	14	13							
7													
8	19	20	21	22	23	24							
9													
10	30	29	28	27	26	25							
11													
12	31	32	33	34	35	36							
13													

A. Description of original monument and accessories and/or subsequent restoration:

L-3 Wood Post set by J. Wampler in 1822. No evidence of original post exists.

L-5 Wood Post set by J. Wampler in 1822. No evidence of original post exists.

B. Description of corner evidence found and/or method applied in restoring or reestablishing corner:

L-3 Found 3/4" pipe. Previous LCRC in L 2 Pg 186. Two recorded subdivisions are tied to this corner and is accepted as the best available evidence of the position of the original corner. Accepted by the Peer Review Group on 10/07/93

L-5 Found 3/4" solid. Previous LCRC recorded in L 1630 Pg 690. One recorded survey is tied to this corner. One recorded subdivision is tied to this corner and is accepted as the best available evidence of the position of the original corner. Accepted by the Peer Review Group on 10/07/93

C. Description of monument for corner and accessories established to perpetuate locating the position of the corner:

L-3 3" Brass Disk in monument box

L-5 3" Brass Disk in monument box

N15°E 65.79' Nail & Tag SW fce most NE'ly guardrail post N. side Univ. Drain
S85°E 39.74' Nail & Tag in N fce pwr pole
S40°E 95.23' Nail & Tag in W fce 30" Oak
S03°W 35.28' NW cor conc footing of flag pole

N45°E 34.50' Nail & Tag SW fce pwr pole
N45°W 56.72' Nail & Tag SE fce pwr pole
N65°W 47.47' Nail & Tag SE fce pwr pole
S45°W 32.15' Nail & Tag NE fce pwr pole


Signed by

Brian D Ferguson
26454

Date

10-20-93

Surveyor's Michigan License No.

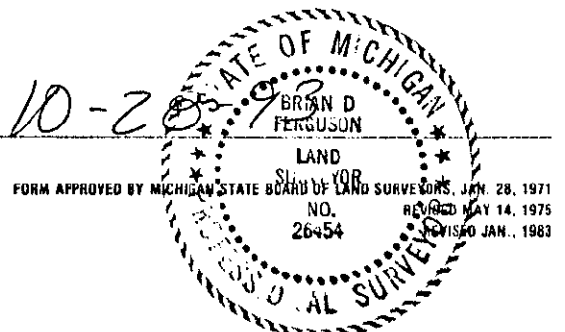

11/18/93