

**SURVEY & REMONUMENTATION**

DEC 15 1993

LIBER 1887 PAGE 629

Lib 6 Page 156

COMMISSION

**LAND CORNER RECORDATION CERTIFICATE**  
Filing Requirement of Act 74, Mich. P.A. 1970

RECORDED  
< Filed

DEC 8 3 30 PM '93

HILLARY DODAK  
REGISTER OF DEEDS  
SACIRAW COUNTY MICH.

For corners in

Saginaw

(County)

Located In:

Corner Code :##

1. Public Land Survey

T 12N R 4E  
T 12N R 4E

M-3  
M-5

2. Property Controlling in Section

S T R

3. Miscellaneous

S T R

Property in Sec.

S T R

4. Lot No. \_\_\_\_\_ Recorded Plat \_\_\_\_\_

5. Private Claims \_\_\_\_\_

Register of Deeds Stamp & File Number

	A	B	C	D	E	F	G	H	I	J	K	L	M
2	6	5	4	3	2	1							
3													
4	7	8	9	10	11	12							
5													
6	18	17	16	15	14	13							
7													
8	19	20	21	22	23	24							
9													
10	30	29	28	27	26	25							
11													
12	31	32	33	34	35	36							
13													

I, Brian D Ferguson, in a field survey on September 30, 19 93, do hereby certify that under requirements of P.A. 74, Michigan P.A. of 1970, the corner points mentioned in lines 1 and 2 above were in conformance with regulations and rules therefore as required in the current manual of survey instructions of the United States Department of the Interior, Bureau of Land Management or by a decree of a Court of Law and/or that the corner points mentioned in lines 3, 4 and 5 above were in conformance with the rules of the Michigan Board of Land Surveyors or by a Decree of a Court of Law; established, re-established, monumented, re-monumented, recovered, found as expressed below:

NOTE: Not more than 4 corners, all in the same town and range, may be recorded on this certificate.

A. Description of original monument and accessories and/or subsequent restoration:

M-3 Wood post set by J. Wampler in 1822. No evidence of original post exists.

M-5 Wood post set by J. Wampler in 1822. No evidence of original post exists.

B. Description of corner evidence found and/or method applied in restoring or reestablishing corner:

M-3 Set on-line between M-5 and M-2 at single proportionate distance. and is accepted as the best available evidence of the position of the original corner. Accepted by the Peer Review Group on 11/12/93

M-5 Set on-line extended E'ly from L-5 & Monument box @ Shattuck & Carrollton Rd's, on section line, based on information from recorded plat to NW and information obtained from Spicer Engineering and is accepted as the best available evidence of the position of the original corner. Accepted by the Peer Review Group on 11/12/93

C. Description of monument for corner and accessories established to perpetuate locating the position of the corner:

M-3 3" Brass Disk in monument box


N42°E 316.59' 3/4" pipe in ctr line of Gladstone & Hickory Streets  
S73°W 259.43' Top ctr hydrant @ SE corner of Gladstone & Mapleridge Streets  
S76°W 259.43' 3/4" pipe in ctr line of Gladstone & Mapleridge Streets  
N85°W 58.10' Nail & tag E fce 8" tree  
N45°W 81.40' Physical ctr line Gladstone St.

M-5 3" Brass Disk in monument box

West 301.00' Boat spike in Monument box - Shattuck Rd @ Carrollton Rd.  
S42°E 98.55' US Corp Eng. marker #107A dated 1957  
N45°W 54.90' Nail & tag S fce 30" Maple  
S80°E 99.88' 3/4" pipe in 1.5' diam. conc base

Signed by Brian D Ferguson  
Surveyor's Michigan License No. 26454

Date \_\_\_\_\_

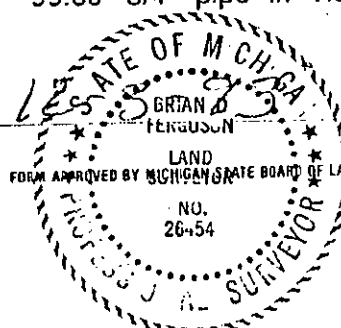

FORM APPROVED BY MICHIGAN STATE BOARD OF LAND SURVEYORS, JAN. 28, 1971  
REVISED MAY 14, 1975  
REVISED JAN., 1983