

SAGINAW COUNTY REMONUMENTATION

Liber 6 Page 294

LAND CORNER RECORDATION CERTIFICATE
Filing Requirement of Act 74, Mich. P.A. 1970

For corners in

Saginaw (County) **SURVEY & REMONUMENTATION** Located In: Corner Code #
APR 24 1995
COMMISSION

1. Public Land Survey	T	12N	R	5E	A12
	T		R		
	T		R		
	T		R		
2. Property in Section	T		R		
	S		T	R	
3. Miscellaneous Property in Sec.	S		T	R	
	S		T	R	

DEC 29 9 31 AM '94
MILDRED M. DOZAK
REGISTER OF DEEDS
SAGINAW COUNTY MICH.

RECORDED & FILED

Register of Deeds Stamp & File Number

4. Lot No. _____, Recorded Plat _____
 5. Private Claims _____

A	B	C	D	E	F	G	H	I	J	K	L	M
2	6	5	4	3	2	1						
3												
4	7	8	9	10	11	12						
5												
6	18	17	16	15	14	13						
7												
8	19	20	21	22	23	24						
9												
10	30	29	28	27	26	25						
11												
12	31	32	33	34	35	36						
13												

I, Duane F. Ledy, in a field survey on July 27, 1994, do hereby certify that under requirements of P.A. 74, Michigan P.A. of 1970, the corner points mentioned in lines 1 and 2 above were in conformance with regulations and rules therefore as required in the current manual of survey instructions of the United States Department of the Interior, Bureau of Land Management or by a decree of a Court of Law and/or that the corner points mentioned in lines 3, 4 and 5 above were in conformance with the rules of the Michigan Board of Land Surveyors or by a Decree of a Court of Law; established, re-established, monumented, re-monumented, recovered, found as expressed below:

NOTE: Not more than 4 corners, all in the same town and range, may be recorded on this certificate.

A. Description of original monument and accessories and/or subsequent restoration:


A-12 No corner set by G.L.O.
 City of Saginaw 1922 resurvey maps show position of A-12.
 No recorded evidence of position available to refute city information.

B. Description of corner evidence found and/or method applied in restoring or reestablishing corner:

A-12 Found 2" City of Saginaw cast iron monument 14.05' south of M-12.
 No L.C.R.C.'s or surveys recorded to verify position of existing monument.
 Position of existing monument accepted as best possible position of original corner.
 Position accepted by Saginaw County Peer Review Group on December 7, 1994.

C. Description of monument for corner and accessories established to perpetuate locating the position of the corner:

A-12 Stamped top of existing 2" City of Saginaw cast iron monument with 21575 and set in monument box.
 N 45° E 22.25' to PK nail in south face of utility pole
 S 80° E 72.32' to NW corner of building foundation
 S 45° W 19.74' to city monument at centerline of streets
 N 60° W 54.30' to PK nail in south face of utility pole
 S 45° W 64.28' to PK nail in SE face of utility pole
 North 14.05' to M-12
 West 16.5' to centerline of Sheridan Road

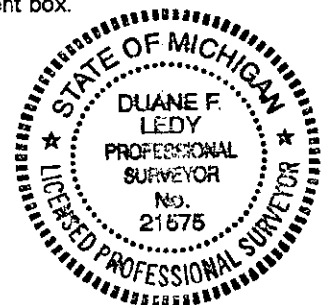

Signed by Duane F. Ledy Date December 27, 1994
 Surveyor's Michigan License No. 21575