

JAN 2 1999

LIBER 2084 PAGE 227

APPROVED BY PEER GROUP
P.A. 345 OF 1990
SAGINAW COUNTY

319 8-5-98

SAGINAW COUNTY REMONUMENTATION
LAND CORNER RECORDATION CERTIFICATE
Filing Requirement of Act 74, Mich. P.A. 1970

1998 OCT -5 A 9:48
MILDRED M. DODAK
REGISTER OF DEEDS
SAGINAW COUNTY, MI.

RECORDED/FILED

Liber 7 Page 205

Register of Deeds Stamp & File Number

Public Land Survey
SAGINAW COUNTY
(County)

Located In: BLUMFIELD
Corner Code #

Public Land Survey	T <u>12N</u> R <u>6E</u>	<u>C-1</u>
	T _____ R _____	_____
	T _____ R _____	_____
	T _____ R _____	_____
Property Controlling in Section	S _____ T _____ R _____	_____
	S _____ T _____ R _____	_____
Miscellaneous Property in Sec.	S _____ T _____ R _____	_____
	S _____ T _____ R _____	_____

Lot No. _____, Recorded Plat _____

Private Claims _____

DALE L. WINECKE, in a field survey on JUNE 10, 1998 do hereby state that under requirements of P.A. 74, Michigan P.A. of 1970, the corner points mentioned in lines 1 and 2 above were in conformance with regulations and rules therefore as required in the current manual of survey instructions of the United States Department of the Interior, Bureau of Land Management or by a decree of a Court of Law and/or that the corner points mentioned in lines 3, 4 and 5 above were in conformance with the rules of the Michigan Board of Land Surveyors or by a Decree of a Court of Law; established, re-established, monumented, recovered, found as expressed below:

NOTE: Not more than 2 corners, all in the same town and range, may be recorded on this certificate.

A	B	C	D	E	F	G	H	I	J	K	L	M
1												
2	6		5		4		3		2		1	
3												
4	7		8		9		10		11		12	
5												
6	18		17		16		15		14		13	
7												
8	19		20		21		22		23		24	
9												
10	30		29		28		27		26		25	
11												
12	31		32		33		34		35		36	
13												

Description of original monument and accessories and/or subsequent restoration:


- C-1
- 1. POST SET BY ORANGE RISDON, D.S., APRIL 2, 1834. POST SET 36.54 CHAINS NORTH OF C-2 AND 42 LINKS WEST OF C-13, T13N, R6E. 12" TAMARACK, S50°E, 10 LINKS; 10" TAMARACK, S55°W, 42 LINKS.
- 2. CERTIFICATE OF SURVEY, L.1096, P.427, D. BURGIN, PS#29240. (1988), TIE TO C-1 FROM C-13, T13N, R6E.
- 3. SAGINAW COUNTY ROAD COMMISSION WITNESSES (1993). MONUMENT BOX SET BY ROAD COMMISSION (1995).

Description of corner evidence found and/or method applied in restoring or reestablishing corner:

C-1
SEARCHED APPARENT LOCATION OF THE CORNER AND FOUND 5/8" X 37" REROD IN MONUMENT BOX.
CHECKED WITNESSES FROM SAGINAW COUNTY ROAD COMMISSION S38°W TO FOUND NAIL/TAG SE CORNER GUARD POST, WEST SIDE OF ROAD, CENTER POST 35.50' (R) 35.45' (M). N60°E TO FOUND NAIL/TAG IN SOUTH SIDE OF U.POLE 55.15' (R&M). N60°W TO FACE OF 11" MAPLE TREE, 8" MAPLE TREE (R) 73.77' (R) 73.55' (M) SAGINAW COUNTY ROAD COMMISSION SET MONUMENT BOX IN 1995.
DISTANCE CHECKED FROM SURVEY IN L. 1096, P.427 27.75'(R) 27.58' (M).
EXCAVATED UNDER THE 5/8" REROD AND FOUND NO OTHER OBJECTS.
ACCEPTED 5/8" REROD AS BEST AVAILABLE EVIDENCE OF THE POSITION OF THE ORIGINAL CORNER. CORNER SET ON LINE BETWEEN B-1 AND C-13, T13N, R6E

Description of monument for corner and accessories established to perpetuate locating the position of the corner:

C-1
RESET 5/8" X 37" REROD IN MONUMENT BOX AFTER EXCAVATION WITH SAGINAW COUNTY REMONUMENTATION CAP.
N56°W 111.13 SE CORNER HOUSE FOUNDATION.
EAST 27.58' TO FOUND 'T' - IRON, C-13, T13N, R6E.
N05°W 155.69' SET NAIL/TAG WEST FACE POWER POLE.
N67°E 55.19' SET NAIL/TAG NORTHWEST FACE POWER POLE.
S31°E 30.46' SET NAIL/TAG NORTHWEST CORNER GUARDRAIL POST, CENTER GUARD POST, EAST SIDE ROAD.
S38°W 35.43' (35.5 R) TO FOUND NAIL/TAG SE CORNER GUARD POST, WEST SIDE OF ROAD, CENTER POST.
N60°E 55.15' (55.15' R) TO FOUND NAIL/TAG IN SOUTH SIDE OF U.POLE.
N60°W 73.55' (73.77' R) TO THE FACE OF 11" MAPLE TREE.

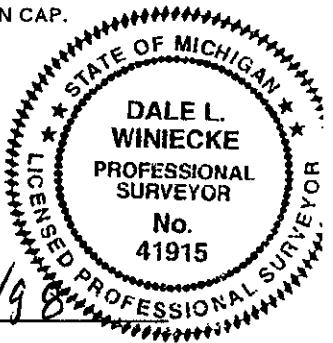

Signed by Dale Winecke
Surveyor's Michigan License No. 41915

Date 9/30/98