

1998

APPROVED BY PEER GROUP  
P.A. 845 OF 1990  
SAGINAW COUNTY  
8-5-98

SAGINAW COUNTY REMONUMENTATION  
LAND CORNER RECORDATION CERTIFICATE  
Filing Requirement of Act 74, Mich. P.A. 1970

Lib 7 Page 206

SAGINAW COUNTY

(County)

Located In: **BLUMFIELD**  
Corner Code #

1998 OCT -5 A 9:49  
MILFRED M. DODD  
REGISTER OF DEEDS  
SAGINAW COUNTY, MI.

RECORDED/FILED

Register of Deeds Stamp & File Number

- 1. Public Land Survey T 12N R 6E D-1  
T \_\_\_ R \_\_\_  
T \_\_\_ R \_\_\_  
T \_\_\_ R \_\_\_
- 2. Property Controlling S \_\_\_ T \_\_\_ R \_\_\_  
in Section S \_\_\_ T \_\_\_ R \_\_\_
- 3. Miscellaneous S \_\_\_ T \_\_\_ R \_\_\_  
Property in Sec. S \_\_\_ T \_\_\_ R \_\_\_

4. Lot No. \_\_\_\_\_, Recorded Plat \_\_\_\_\_

5. Private Claims \_\_\_\_\_

I, DALE L. WINIECKE, in a field survey on JUNE 10, 1998 do hereby state that under requirements of P.A. 74, Michigan P.A. of 1970, the corner points mentioned in lines 1 and 2 above were in conformance with regulations and rules therefore as required in the current manual of survey instructions of the United States Department of the Interior, Bureau of Land Management or by a decree of a Court of Law and /or that the corner points mentioned in lines 3, 4 and 5 above were in conformance with the rules of the Michigan Board of Land Surveyors or by a Decree of a Court of Law; established, re-established, monumented, recovered, found as expressed below:

NOTE: Not more than 2 corners, all in the same town and range, may be recorded on this certificate.

	A	B	C	D	E	F	G	H	I	J	K	L	M
1				●									
2	6			5	4			3		2			1
3													
4	7			8	9			10		11			12
5													
6	18			17	16			15		14			13
7													
8	19			20	21			22		23			24
9													
10	30			29	28			27		26			25
11													
12	31			32	33			34		35			36
13													

A. Description of original monument and accessories and/or subsequent restoration:

D-1

- 1. POST NOT SET IN ORIGINAL GOVERNMENT SURVEY BY ORANGE RISDON, D.S., APRIL 2, 1834.
- 2. LCRC, L.1653, P.629, RONALD PREVOST, PS#24612, (1984) FOUND 1/2" REBAR.
- 3. CERTIFICATE OF SURVEY, L.1307, P.633, D. BURGIN, PS#29240, (1991), DISTANCE TO D-1 FROM D-13, T13N, R6E.
- 4. CERTIFICATE OF SURVEY, L.1096, P.427, D. BURGIN, PS#29240, (1988), DISTANCE TO D-1 FROM D-13, T13N, R6E.

B. Description of corner evidence found and/or method applied in restoring or reestablishing corner:


D-1

SEARCHED APPARENT LOCATION OF CORNER AND FOUND 1/2" REROD 18" LONG, 0.40' BELOW THE SURFACE. EXCAVATED AREA AND FOUND A CLAY TILE 1.7' BELOW SURFACE, WITH 1" PIPE IN THE CENTER. ALSO FOUND WOOD FRAGMENTS. CHECKED THE ONE REMAINING WITNESS FROM LCRC BY PREVOST (11.5' R ± 6' M) TO CENTERLINE ROAD. ALSO FOUND 5/8" REBAR SOUTH OF 1/2" REROD. THE TWO CERTIFICATES OF SURVEY USE THIS POINT AS D-1. ACCEPTED 1/2" REROD AS THE BEST AVAILABLE EVIDENCE OF THE POSITION OF THE ORIGINAL CORNER.

C. Description of monument for corner and accessories established to perpetuate locating the position of the corner:

D-1

SET 5/8" X 24" REROD WITH SAGINAW COUNTY REMONUMENTATION CAP IN MONUMENT BOX.  
6' SOUTH OF CENTERLINE ROAD.  
6' EAST OF CENTERLINE BURNS ROAD TO NORTH.  
S08°W 5.58' TO FOUND 5/8" REROD  
N25°W 47.90' TO THE CENTERLINE OF STOP SIGN POST.  
N09°E 33.15' SET 1/2" REBAR WITH CAP #29240 WTI.  
N56°W 47.45' SET 1/2" REBAR WITH CAP #29240 WTI.

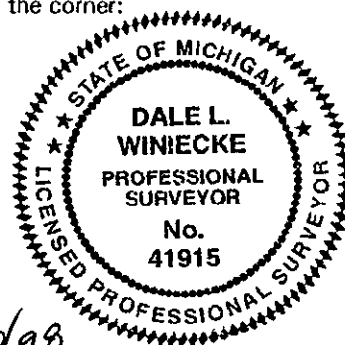

Signed by Dale Winiecke

Date 9/30/98

Surveyor's Michigan License No. 41915