PPROVED BY PEER GROUP
P.A. 345 OF 1990
SAGINAW COUNTY
8-19-98

LIBER 2084 PAGE 234

SAGINAW COUNTY REMONUMENTATION
LAND CORNER RECORDATION CERTIFICATE
Filing Requirement of Act 74, Mich. P.A. 1970

RECORDED/FILED
1998 OCT -5 A 9:49
MILDRED M. DODAK
REGISTER OF DEEDS
SAGINAW COUNTY, MI.

Liber 7 Page 212
Register of Deeds Stamp & File Number

For corners in

SAGINAW COUNTY
(County)

Located In: BLUMFIELD
Corner Code #

1. Public Land Survey		T ~~13N~~ 12	R 6E	J-1
		T____	R____	
		T____	R____	
		T____	R____	
2. Property Controlling	S____	T____	R____	
in Section	S____	T____	R____	
3. Miscellaneous	S____	T____	R____	
Property in Sec.	S____	T____	R____	

4. Lot No. _____ , Recorded Plat _____

5. Private Claims _____

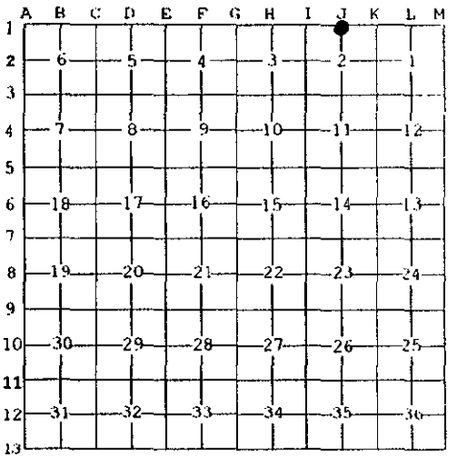

I, DALE L. WINIECKE, in a field survey on JUNE 12, 19 98 do hereby state that under requirements of P.A. 74, Michigan P.A. of 1970, the corner points mentioned in lines 1 and 2 above were in conformance with regulations and rules therefore as required in the current manual of survey instructions of the United States Department of the Interior, Bureau of Land Management or by a decree of a Court of Law and /or that the corner points mentioned in lines 3, 4 and 5 above *were in conformance with the rules of the Michigan Board of Land Surveyors or by a Decree of a* Court of Law; established, re-established, monumented, recovered, found as expressed below:

NOTE: Not more than 2 corners, all in the same town and range, may be recorded on this certificate.

A. Description of original monument and accessories and/or subsequent restoration:

J-1

CORNER NOT SET IN ORIGINAL GOVERNMENT SURVEY. NO OTHER RECORDED INFORMATION

B. Description of corner evidence found and/or method applied in restoring or reestablishing corner:

J-1

SEARCHED APPARENT LOCATION OF THE CORNER AND NO CORNER WAS FOUND. CORNER WAS ESTABLISHED MIDWAY AND ON LINE BETWEEN I-1 T13N, R6E AND K-1 T13N, R6E.

C. Description of monument for corner and accessories established to perpetuate locating the position of the corner:

J-1

SET 5/8"x 24" REROD WITH SAGINAW COUNTY REMONUMENTATION CAP IN MONUMENT BOX.
WEST 34.93' TO 3/4" PIPE J-13 T13N, R6E
S65°E 47.28' TO CHISELED "X" IN THE TOP OF 72" RCP.
N30°W 31.40' TO SET 1/2" REBAR WITH CAP PS#41915.
N45°E 30.74' TO SET 1/2"REBAR WITH CAP PS#41915.
NORTH 13.0' TO THE CENTERLINE OF WILSHIRE DRIVE.

Signed by Dale Winiecke Date 9/30/98

Surveyor's Michigan License No. 41915

STATE OF MICHIGAN
DALE L. WINIECKE
PROFESSIONAL SURVEYOR
No. 41915
LICENSED PROFESSIONAL SURVEYOR

FORM APPROVED BY MICHIGAN STATE BOARD OF PROFESSIONAL SURVEYORS, JAN. 28, 197
REVISED MAY 14,197
REVISED JAN., 198
REVISED OCT., 199

SURVEY &
MAPPING STATION
MAR 3 2 1999
SECTION