

1998

LIBER 2084 PAGE 235

APPROVED BY PEER GROUP
P.A. 345 OF 1990
SAGINAW COUNTY
Bill B-19-98

SECTION
SAGINAW COUNTY REMONUMENTATION
LAND CORNER RECORDATION CERTIFICATE
Filing Requirement of Act 74, Mich. P.A. 1970

1998 OCT -5 A 9:49
MILFRED H. GODAK
REGISTER OF DEEDS
SAGINAW COUNTY, MI.

RECORDED/FILED

Liber 7 Page 213

Register of Deeds Stamp & File Number

For corners in

SAGINAW COUNTY

Located In: **BLUMFIELD**
Corner Code #

(County)

- 1. Public Land Survey T 12N R 6E _____ K-1
T _____ R _____
T _____ R _____
T _____ R _____
- 2. Property Controlling S _____ T _____ R _____
in Section S _____ T _____ R _____
- 3. Miscellaneous S _____ T _____ R _____
Property in Sec. S _____ T _____ R _____

4. Lot No. _____, Recorded Plat _____

5. Private Claims _____

I, DALE L. WINIECKE, in a field survey on JUNE 12, 1998 do hereby state that under requirements of P.A. 74, Michigan P.A. of 1970, the corner points mentioned in lines 1 and 2 above were in conformance with regulations and rules therefore as required in the current manual of survey instructions of the United States Department of the Interior, Bureau of Land Management or by a decree of a Court of Law and for that the corner points mentioned in lines 3, 4 and 5 above were in conformance with the rules of the Michigan Board of Land Surveyors or by a Decree of a Court of Law; established, re-established, monumented, recovered, found as expressed below:

NOTE: Not more than 2 corners, all in the same town and range, may be recorded on this certificate.

	A	B	C	D	E	F	G	H	I	J	K	L	M
1													
2		6		5		4		3		2			
3													
4		7		8		9		10		11		12	
5													
6		18		17		16		15		14		13	
7													
8		19		20		21		22		23		24	
9													
10		30		29		28		27		26		25	
11													
12		31		32		33		34		35		36	
13													

A. Description of original monument and accessories and/or subsequent restoration:


- K-1
- 1. POST SET BY ORANGE RISDON APRIL 2, 1834. POST SET 50 LINKS EAST OF K-13 T13N, R6E. 10" ELM S15°E 31 LINKS; 10" BLACK ASH S39°W, 37 LINKS.
- 2. LCRC RECORDED L.3, P.209, R. TOMMER JR, PS#22444, (1976) NO POINT SET AS IT FALLS IN THE CENTER OF A DITCH, POSITION ESTABLISHED BY GLO PRORATION AT 32.40' EAST FROM K-13 T13N, R6E.
- 3. CERTIFICATE OF SURVEY RECORDED IN L.1474, P.750, A. LEACH, PS#7236 (1976), NO POINT AS IT FALLS IN A DITCH.
- 4. SPICER ENGINEERING NOTES SHOWING POINT FALLING 32.90' EAST OF K-13 ,T13N, R6E.

B. Description of corner evidence found and/or method applied in restoring or reestablishing corner:

- K-1
- SEARCHED APPARENT LOCATION OF THE CORNER AND IT FALLS IN THE SIDE OF A DETERIORATED HEADWALL. LOCATION ESTABLISHED AT 32.90' EAST OF K-13 T13N, R6E AS DETERMINED IN THE 1993 BAY COUNTY REMONUMENTATION PROGRAM ON A LINE BETWEEN SAID K-13 AND M-13 T13N, R6E.
- REROD WITH CAP SET 30.00' SOUTH OF THE TRUE CORNER ON LINE BETWEEN CALCULATED POSITION OF K-1 AND K-2.
- SAGINAW COUNTY REMONUMENTATION CAP IS STAMPED "WITNESS CORNER".

C. Description of monument for corner and accessories established to perpetuate locating the position of the corner:

- K-1
- SET 5/8" X 24" REROD WITH SAGINAW COUNTY REMONUMENTATION CAP STAMPED "WITNESS CORNER".
- N46°W 44.62' TO K-13 T13N, R6E
- SOUTH 1.95' SET NAIL & TAG IN TOP OF GUARD RAIL POST.
- N06°W 39.56' TO SET NAIL & TAG IN TOP OF GUARD RAIL POST.
- N56°W 41.74' TO SET NAIL & TAG IN TOP OF GUARD RAIL POST.
- S45°W 37.91' TO SET NAIL & TAG IN TOP OF GUARD RAIL POST.
- SOUTH 2408.09' TO K-2, T12N, R6E TO A FOUND 1/2" REBAR.

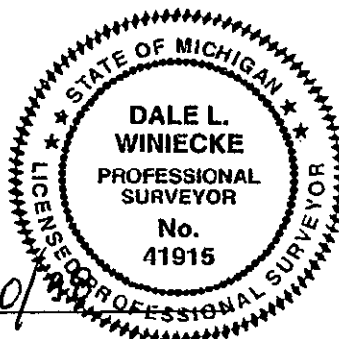

Signed by Dale Winiecke

Date 9/30/98

Surveyor's Michigan License No. 41915