

JUN 12 1998

APPROVED BY PEER GROUP
P.A. 345 OF 1990
SAGINAW COUNTY

BL 9298

SAGINAW COUNTY REMONUMENTATION
LAND CORNER RECORDATION CERTIFICATE
Filing Requirement of Act 74, Mich. P.A. 1970

LIBER 2084 PAGE 236

MILDRED M. DODAK
REGISTER OF DEEDS
SAGINAW COUNTY, MI.

1998 OCT - 5 A 9:49

RECORDED/FILED

For corners in

SAGINAW COUNTY

(County)

Located In: **BLUMFIELD**
Corner Code #

- 1. Public Land Survey T 12N R 6E L-1
T _____ R _____
T _____ R _____
T _____ R _____
- 2. Property Controlling S _____ T _____ R _____
in Section S _____ T _____ R _____
- 3. Miscellaneous S _____ T _____ R _____
Property in Sec. S _____ T _____ R _____

Liber 7 Page 214

Register of Deeds Stamp & File Number

4. Lot No. _____, Recorded Plat _____

5. Private Claims _____

I, DALE L. WINIECKE, in a field survey on JUNE 12, 19 98 do hereby state that under requirements of P.A. 74, Michigan P.A. of 1970, the corner points mentioned in lines 1 and 2 above were in conformance with regulations and rules therefore as required in the current manual of survey instructions of the United States Department of the Interior, Bureau of Land Management or by a decree of a Court of Law and for that the corner points mentioned in lines 3, 4 and 5 above were in conformance with the rules of the Michigan Board of Land Surveyors or by a Decree of a Court of Law; established, re-established, monumented, recovered, found as expressed below:

NOTE: Not more than 2 corners, all in the same town and range, may be recorded on this certificate.

	A	B	C	D	E	F	G	H	I	J	K	L	M
1													
2		6		5		4		3		2		1	
3													
4		7		8		9		10		11		12	
5													
6		18		17		16		15		14		13	
7													
8		19		20		21		22		23		24	
9													
10		30		29		28		27		26		25	
11													
12		31		32		33		34		35		36	
13													

A. Description of original monument and accessories and/or subsequent restoration:


- L-1
- 1. CORNER NOT SET IN ORIGINAL GOVERNMENT SURVEY BY ORANGE RISDON D.S., 1834
- 2. CONSUMERS POWER COMPANY FEE STRIP SURVEY, G. FAUSER, PS#18657, 1972

B. Description of corner evidence found and/or method applied in restoring or reestablishing corner:

L-1
SEARCHED APPARENT LOCATION OF THE CORNER AND FOUND A 3/4" PIPE AND A 1993 BAY COUNTY REMONUMENTATION CORNER FOR L-13, T13N, R6E. CORNERS K-13 AND M-13, T13N, R6E WERE ALSO REMONUMENTED BY BAY COUNTY IN 1993. M-13 IS COMMON WITH T13N, R6E AND M-1 T12N, R6E. L-1 WAS SET MIDWAY AND ON LINE BETWEEN K-1 AND M-1, T12N, R6E. THE 3/4" PIPE WAS USED BY SPICER ENGINEERING IN PREVIOUS SURVEY WORK AND IS 4.14' SOUTH OF THE LINE BETWEEN L-1 AND M-1 AND 5.48' EAST OF THE REESTABLISHED LOCATION OF L-1. REESTABLISHED CORNER ACCEPTED AS THE BEST AVAILABLE EVIDENCE OF THE POSITION OF THE ORIGINAL CORNER.

C. Description of monument for corner and accessories established to perpetuate locating the position of the corner:

L-1
SET 5/8" X 24" REROD WITH SAGINAW COUNTY REMONUMENTATION CAP. N12°E 458.42' SET 1/2" REROD WITH PS CAP #41915 ON TOP OF DITCH BANK N06°W 1216.91' TO SOUTHEAST TOWER LEG WEST 2650.41' TO K-13, T13N, R6E, BAY COUNTY REMONUMENTATION CORNER WEST 16.44' TO L-13, T13N, R6E, BAY COUNTY REMONUMENTATION CORNER EAST 2617.52' TO M-13, T13N, R6E, BAY COUNTY REMONUMENTATION CORNER S53°E 6.87' TO FOUND 3/4" PIPE

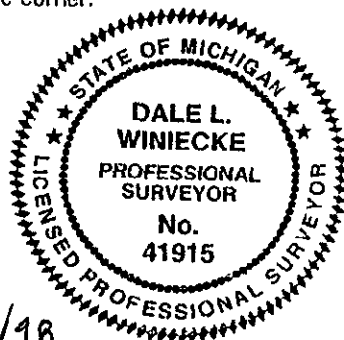

Signed by Dale Winiecke

Date 9/30/98

Surveyor's Michigan License No. 41915