

SAGINAW COUNTY REMONUMENTATION

RECORDED/FILED

LAND CORNER RECORDATION CERTIFICATE  
Filing Requirement of Act 74, Mich. P.A. 1970

For corners in

<u>Saginaw</u> (County)	Located In: BLUMFIELD	Corner Code #
1. Public Land Survey	T <u>12N</u> R <u>6E</u>	<u>M-4</u>
	T ___ R ___	_____
	T ___ R ___	_____
	T ___ R ___	_____
2. Property Controlling in Section	S ___ T ___ R ___	_____
	S ___ T ___ R ___	_____
3. Miscellaneous Property in Sec.	S ___ T ___ R ___	_____
	S ___ T ___ R ___	_____

1997 SEP 26 P 3: 30

MILDRED M. DODAK  
REGISTER OF DEEDS  
SAGINAW COUNTY, MI.

LIBER 2027 PAGE 478

*Liber 7 Page 169*

Register of Deeds Stamp & File Number

4. Lot No. \_\_\_\_\_, Recorded Plat \_\_\_\_\_

5. Private Claims \_\_\_\_\_

I, Michael J. MacDonald, in a field survey on JUNE 24, 1997  
do hereby state that under requirements of P.A. 74, Michigan P.A. of 1970, the corner points  
mentioned in lines 1 and 2 above were in conformance with regulations and rules therefore as  
required in the current manual of survey instructions of the United States Department of the Interior,  
Bureau of Land Management or by a decree of a Court of Law and /or that the corner points  
mentioned in lines 3, 4 and 5 above were in conformance with the rules of the Michigan Board of  
Land Surveyors or by a Decree of a Court of Law; established, re-established, monumented,  
recovered, found as expressed below:

	A	B	C	D	E	F	G	H	I	J	K	L	M
1													
2		6		5		4		3		2		1	
3													
4		7		8		9		10		11		12	
5													
6		18		17		16		15		14		13	
7													
8		19		20		21		22		23		24	
9													
10		30		29		28		27		26		25	
11													
12		31		32		33		34		35		36	
13													

NOTE: Not more than 2 corners, all in the same town and range, may be recorded on this certificate.

A. Description of original monument and accessories and/or subsequent restoration:

M-4 SET POST BY J. WAMPLER D.S.  
LYNN 13° S 323° E 9 L.  
ASH 16° N 47° W 15 L.

L.C.R.C., L.2.P. 228- 1974- MARTIN, FND BOLT WITH 1" SQUARE HEAD  
RECORDED SURVEY, L.767 ,P.2537- 1975- MCGINNIS, FND BOAT SPIKE  
L.C.R.C., L.3 ,P. 205- 1975- MCGINNIS, FND BOAT SPIKE  
RECORDED SURVEY, L.1499 ,P. 933- 1976- HAMMOND, FND 1" SQ. HEAD BOLT  
RECORDED SURVEY, L.1563 ,P.423- 1978- DUNTON, FND BOAT SPIKE  
L.C.R.C., L. 4,P. 220- 1979- ROWE, FND BOAT SPIKE

APPROVED BY PEER GROUP  
P.A. 345 OF 1990  
SAGINAW COUNTY

*6-26-97 [Signature]*

B. Description of corner evidence found and/or method applied in restoring or reestablishing corner:

M4 FOUND BOAT SPIKE, RECORDED WITNESSES ( L.C.R.C., L.2.P. 228 SURVEY, L.767 ,P.2537; L.C.R.C., L.3 ,P. 205; SURVEY, L.1499 , P. 933; SURVEY, L.1563 ,P.423; L.C.R.C. L. 4,P. 220) VERIFY THE LOCATION OF THE BOAT SPIKE. MONUMENT ACCEPTED AS THE BEST AVAILABLE EVIDENCE OF THE POSITION OF THE ORIGINAL CORNER.


C. Description of monument for corner and accessories established to perpetuate locating the position of the corner:

M-4 REPLACED BOAT SPIKE WITH SAGINAW COUNTY REMONUMENTATION CAP ON 5/8" x 18" LONG REBAR IN MONUMENT BOX.  
N 25° E 30.71' SET CAPPED 3/8" REROD  
N 40° E 55.30' SET NAIL AND TAG IN NW FACE PP  
N 60° E 40.16' TO NOTCH IN NW COR OF NW TOWER LEG  
N 85° E 33.65' TO NOTCH IN SW COR OF SW TOWER LEG  
EAST 33.05' TO CONC. MONUMENT  
S 55° E 39.81' SET NAIL AND TAG IN SW FACE 12" PINE  
S 25° E 35.65' SET CAPPED 3/8" REROD

SURVEY &  
REMONUMENTATION

MAR 18 1998

SECTION

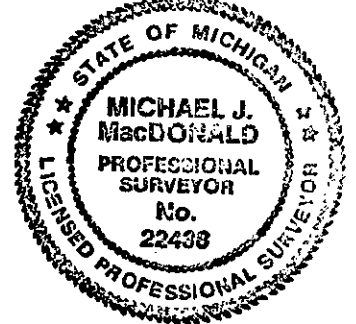

Signed by Michael J. MacDonald

Date 9/25/97

Surveyor's Michigan License No. 22438