

SAGINAW COUNTY REMONUMENTAION

RECORDED/FILED

LAND CORNER RECORDATION CERTIFICATE  
Filing Requirement of Act 74, Mich. P.A. 1970

For corners in

Saginaw  
(County)

Located In: BLUMFIELD

Corner Code #

- |                                    |                           |            |
|------------------------------------|---------------------------|------------|
| 1. Public Land Survey              | T <u>12N</u> R <u>R6E</u> | <u>M-6</u> |
|                                    | T _____ R _____           | _____      |
|                                    | T _____ R _____           | _____      |
|                                    | T _____ R _____           | _____      |
| 2. Property Controlling in Section | S _____ T _____ R _____   | _____      |
|                                    | S _____ T _____ R _____   | _____      |
| 3. Miscellaneous Property in Sec.  | S _____ T _____ R _____   | _____      |
|                                    | S _____ T _____ R _____   | _____      |

1997 SEP 26 P 3:30

MILDRED M. DODAK  
REGISTER OF DEEDS  
SAGINAW COUNTY, MI.

LIBER 2027 PAGE 480

*Liber 7 Page 171*

Register of Deeds Stamp & File Number

4. Lot No. \_\_\_\_\_, Recorded Plat \_\_\_\_\_

5. Private Claims \_\_\_\_\_

A	B	C	D	E	F	G	H	I	J	K	L
1											
2	6	5	4	3	2	1					
3											
4	7	8	9	10	11	12					
5											
6	18	17	16	15	14	13					
7											
8	19	20	21	22	23	24					
9											
10	30	29	28	27	26	25					
11											
12	31	32	33	34	35	36					
13											

I, Michael J. MacDonald, in a field survey on JUNE 24, 1997 do hereby state that under requirements of P.A. 74, Michigan P.A. of 1970, the corner points mentioned in lines 1 and 2 above were in conformance with regulations and rules therefore as required in the current manual of survey instructions of the United States Department of the Interior, Bureau of Land Management or by a decree of a Court of Law and /or that the corner points mentioned in lines 3, 4 and 5 above were in conformance with the rules of the Michigan Board of Land Surveyors or by a Decree of a Court of Law; established, re-established, monumented, recovered, found as expressed below:

NOTE: Not more than 2 corners, all in the same town and range, may be recorded on this certificate.

A. Description of original monument and accessories and/or subsequent restoration:

M-6 SET POST BY J. WAMPLER D.S.  
BIRCH 16" S 16" E 30 L.  
MAPLE 7" N 44" W 26 L..

RECORDED SURVEY L.1353, P.882-1971-ROWE, SET RR SPIKE  
L.C.R.C., L.2,P. 129- 1973- MARTIN, FND RR SPIKE  
L.C.R.C., L.3, P.85- 1974- MARTIN, 3/4" IRON  
RECORDED SURVEY, L.1563, P.804- 1978- DUNTIN, NO MONUMENT CALLED OUT, NO WIT.  
L.C.R.C., L.4, P.221- 1979- MARTIN, FND 3/4" PIPE, RR SPIKE, AND BOAT SPIKE, HELD 3/4" PIPE  
RECORDED SURVEY, L. 1619, P. 539, FND 3/4" PIPE, ROWE 1979  
SPICER FIELD NOTES, 1983 (DISTANCE)

APPROVED BY PEER GROUP  
P.A. 345 OF 1990  
SAGINAW COUNTY


*B-28-97 BDL*

B. Description of corner evidence found and/or method applied in restoring or reestablishing corner:

M-6 FOUND BOAT SPIKE. PREVIOUS INFORMATION (SURVEY L.1353, P.882; L.C.R.C. L.2,P. 129 AND L.4, P.221) SHOWS OTHER MONUMENTS BEING USED FOR M-6. NO OTHER MONUMENTATION FOUND IN THE AREA. RECORDED WITNESSES(L.C.R.C., L.3, P.85; L.C.R.C., L.4, P.221; RECORDED SURVEY, L. 1619, P. 539,AND SPICER FIELD NOTES, 1983 (DISTANCE M5-M6)) FOR THE FOUND 3/4" PIPE FIT THE LOCATION OF THE BOAT SPIKE. MONUMENT ACCEPTED AS THE BEST AVAILABLE EVIDENCE OF THE POSITION OF THE ORIGINAL CORNER.

C. Description of monument for corner and accessories established to perpetuate locating the position of the corner:

M-6 REPLACED BOAT SPIKE WITH SAGINAW COUNTY REMONUMENTAION CAP ON 5/8" x 18" LONG REROD IN MONUMENT BOX  
N 40° E 29.72' SET CAPPED 3/8" REROD  
EAST 17.79' CHISELED NOTCH IN WEST FACE OF WEST SIGN LEG  
S 50° E 32.95' SET PK NAIL AND TAG IN EAST ND 24" CMP  
S 20° E 81.90' SET NAIL AND TAG IN SW FACE PP  
S 50° W 74.63' NE CORNER CONC. PORCH  
N 10° W 30.39' SET CAPPED 3/8" REROD  
2.0' WEST OF PHY CENTERLINE OF REESE ROAD

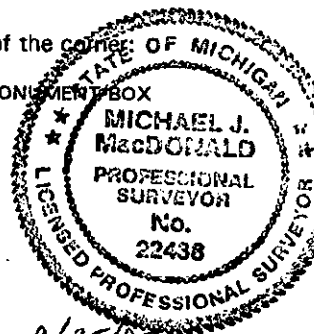

Signed by Michael J. MacDonald

Date 9/25/97

Surveyor's Michigan License No. 22438

SURVEY &  
REMONUMENTATION

FORM APPROVED BY MICHIGAN STATE BOARD OF PROFESSIONAL SURVEYORS, JAN. 28, 197  
REVISED MAY 14, 197  
REVISED JAN., 1991  
REVISED OCT., 1991

MAR 18 1998

SECTION