

**SAGINAW COUNTY REMONUMENTATION  
LAND CORNER RECORDATION CERTIFICATE  
Filing Requirement of Act 74, Mich. P.A. 1970**

RECORDED/FILED

For corners in

<u>Saginaw</u> (County)	Located In: <u>BLUMFIELD</u>	Corner Code #
1. Public Land Survey	<u>T12N R6E</u>	<u>M-7</u>
	T ___ R ___	_____
	T ___ R ___	_____
	T ___ R ___	_____
2. Property Controlling in Section	S ___ T ___ R ___	_____
	S ___ T ___ R ___	_____
3. Miscellaneous Property in Sec.	S ___ T ___ R ___	_____
	S ___ T ___ R ___	_____

1997 SEP 26 P 3: 30  
MILDRED M. DODAK  
REGISTER OF DEEDS  
SAGINAW COUNTY, MI.  
LIBER 2027 PAGE 481  
*Side 7 Page 178*  
Register of Deeds Stamp & File Number

4. Lot No. \_\_\_\_\_, Recorded Plat \_\_\_\_\_  
5. Private Claims \_\_\_\_\_

A	B	C	D	E	F	G	H	I	J	K	L	M
1												
2	6	5	4	3	2	1						
3												
4	7	8	9	10	11	12						
5												
6	10	17	16	15	14	13						
7												
8	19	20	21	22	23	24						
9												
10	30	29	28	27	26	25						
11												
12	31	32	33	34	35	36						
13												

I, Michael J. MacDonald, in a field survey on JUNE 25, 19 97 do hereby state that under requirements of P.A. 74, Michigan P.A. of 1970, the corner points mentioned in lines 1 and 2 above were in conformance with regulations and rules therefore as required in the current manual of survey instructions of the United States Department of the Interior, Bureau of Land Management or by a decree of a Court of Law and /or that the corner points mentioned in lines 3, 4 and 5 above were in conformance with the rules of the Michigan Board of Land Surveyors or by a Decree of a Court of Law; established, re-established, monumented, recovered, found as expressed below:

NOTE: Not more than 2 corners, all in the same town and range, may be recorded on this certificate.


A. Description of original monument and accessories and/or subsequent restoration:  
M-7 SET POST BY J. WAMPLER D.S.  
MAPLE 13° N 42° W 7 L.  
SUGAR 14° S 12° E 8 L..

APPROVED BY PEER GROUP  
P.A. 345 OF 1990  
SAGINAW COUNTY  
*6-26-97*

RECORDED SURVEY L.1353, P.882-1971-ROWE, SET RR SPIKE  
TUSCOLA CO. L.C.R.C., L.5, DENMARK- 1972- DORCEY, FND RR SPIKE  
L.C.R.C., L.4, P. 221- 1979- ROWE, FND 3/4" PIPE 3.80' WEST OF SET RR SPIKE 1971, ACCEPTED 3/4" PIPE AS THE CORNER AS PIPE APPEARS OLDER THAN RR SPIKE SET 1971)

B. Description of corner evidence found and/or method applied in restoring or reestablishing corner:  
M-7 FOUND 3/4" PIPE (RECORDED L.C.R.C L. 4, P. 221 FND. 3/4" PIPE). PREVIOUS SURVEY(L.1353, P.882) AND L.C.R.C.(TUSCOLA CO., DENMARK, P.5) SHOW A RAILROAD SPIKE BEING USED AT M-7, 3.8' EAST OF THE 3/4" PIPE. NO OTHER MONUMENTATION WAS FOUND IN THE AREA. RECORD WITNESSES VERIFY LOCATION OF 3/4"PIPE. MONUMENT ACCEPTED AS THE BEST AVAILABLE EVIDENCE OF THE POSITION OF THE ORIGINAL CORNER.

C. Description of monument for corner and accessories established to perpetuate locating the position of the corner:  
M-7 REPLACED 3/4" PIPE WITH SAGINAW COUNTY REMONUMENTATION CAP ON 5/8" x 18" LONG REROD IN MONUMENT  
N 35° E 34.04' SET CAPPED 3/8" REROD  
N 65° E 38.89' SET NAIL AND TAG IN THE TOP OF CONC. HEADWALL  
S 55° E 41.59' SET NAIL AND TAG IN THE TOP OF CONC. HEADWALL  
S 35° E 32.60' SET CAPPED 3/8" REROD  
S 25° W 56.75' 38.90' 56.75' SET PK NAIL IN WEST END 24" CMP  
S 20° W 33.13' SET CAPPED 3/8" REROD  
S 25° W 38.90' SET PK NAIL IN WEST END 24" CMP  
S 20° W 36.34' SET CAPPED 3/8" REROD

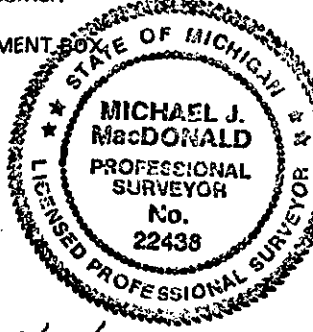

Signed by Michael J. MacDonald Date 9/25/97

Surveyor's Michigan License No. 22438  
**SURVEY & REMONUMENTATION**

MAR 18 1998

SECTION