

SAGINAW COUNTY REMONUMENTATION

RECORDED/FILED

LAND CORNER RECORDATION CERTIFICATE  
Filing Requirement of Act 74, Mich. P.A. 1970

1997 SEP 26 P 3: 31

For corners in

<u>Saginaw</u> (County)	Located In: BLUMFIELD	Corner Code #
1. Public Land Survey	T12N R6E	M-8
	T R	
	T R	
	T R	
2. Property Controlling in Section	S T R	
	S T R	
3. Miscellaneous Property in Sec.	S T R	
	S T R	

MILDRED M. DODAK  
REGISTER OF DEEDS  
SAGINAW COUNTY, MI.  
LIBER 2027 PAGE 482

*Liber 7 Page 173*

Register of Deeds Stamp & File Number

4. Lot No. \_\_\_\_\_, Recorded Plat \_\_\_\_\_

5. Private Claims \_\_\_\_\_

I, Michael J. MacDonald, in a field survey on JUNE 25, 1997  
do hereby state that under requirements of P.A. 74, Michigan P.A. of 1970, the corner points  
mentioned in lines 1 and 2 above were in conformance with regulations and rules therefore as  
required in the current manual of survey instructions of the United States Department of the Interior,  
Bureau of Land Management or by a decree of a Court of Law and /or that the corner points  
mentioned in lines 3, 4 and 5 above were in conformance with the rules of the Michigan Board of  
Land Surveyors or by a Decree of a Court of Law; established, re-established, rgonumented,  
recovered, found as expressed below:

1	A	B	C	D	E	F	G	H	I	J	K	L
2		6		5		4		3		2		1
3												
4		7		8		9		10		11		12
5												
6		18		17		16		15		14		13
7												
8		19		20		21		22		23		24
9												
10		30		29		28		27		26		25
11												
12		31		32		33		34		35		36
13												

NOTE: Not more than 2 corners, all in the same town and range, may be recorded  
on this certificate.

A. Description of original monument and accessories and/or subsequent restoration:

M-8 SET POST BY J. WAMPLER D.S.  
LYNN 12° N 60° E 3 1/2 L.  
LYNN 14° N 83° WE 38 L..  
  
L.C.R.C., L.1, P.216- 1971- MARTIN

APPROVED BY PEER GROUP  
P.A. 345 OF 1990  
SAGINAW COUNTY

*10-26-97*


B. Description of corner evidence found and/or method applied in restoring or reestablishing corner:

M-8 FOUND RAILROAD SPIKE (RECORDED L.C.R.C L. 1, P. 216 RAILROAD SPIKE). RECORD WITNESSES VERIFY LOCATION OF RAILROAD SPIKE.  
MONUMENT ACCEPTED AS THE BEST AVAILABLE EVIDENCE OF THE POSITION OF THE ORIGINAL CORNER.

C. Description of monument for corner and accessories established to perpetuate locating the position of the corner:

REPLACED RAILROAD SPIKE WITH SAGINAW COUNTY REMONUMENTATION CAP ON 5/8"x 18" REROD IN MONUMENT BOX

N 45° E 41.94' SET NAIL AND TAG IN SE FACE TP.  
N 60° E 43.16' SET CAPPED 3/8" REROD.  
S 60° E 42.90' SET CAPPED 3/8" REROD.  
S 20° E 41.39' SET NAIL AND TAG IN EAST END 18" CMP.  
S 25° W 39.60' SET NAIL AND TAG IN WEST END 18" CMP.  
S 40° W 21.00' SET CAPPED 3/8" REROD.  
N 25° W 26.35' SET CAPPED 3/8" REROD.

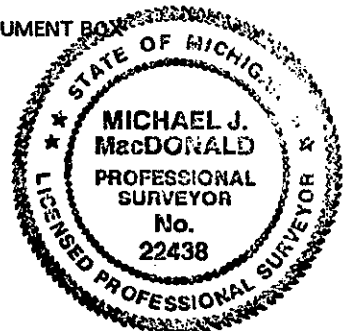

Signed by Michael J. MacDonald

Date 9/25/97

Surveyor's Michigan License No. 22438

SURVEY &  
REMONUMENTATION

MAR 18 1998

SECTION