

APPROVED BY PEER GROUP
P.A. 345 OF 1990
SAGINAW COUNTY

1997 REMONUMENTATION PROGRAM
LAND CORNER RECORDATION CERTIFICATE
Filing Requirement of Act 74, Mich. P.A. 1970

RECORDED/FILED
LIBER 2028 PAGE 446

For corners in: BLUMFIELD TWP.

1997 OCT -3 A 8:29

MILDRED M. DODAK
REGISTER OF DEEDS
SAGINAW COUNTY, MI.

SAGINAW (County)	Located In:	Corner Code #
1. Public Land Survey	T <u>12N</u> R <u>06E</u>	<u>M-10</u>
	T _____ R _____	_____
	T _____ R _____	_____
	T _____ R _____	_____
2. Property Controlling in Section	S _____ T _____ R _____	_____
	S _____ T _____ R _____	_____
3. Miscellaneous Property in Sec.	S _____ T _____ R _____	_____
	S _____ T _____ R _____	_____

See Page 191

Register of Deeds Stamp & File Number

4. Lot No. _____ Recorded Plat _____
5. Private Claims _____

	A	B	C	D	E	F	G	H	I	J	K	L
1												
2	6	5	4	3	2	1						
3												
4	7	8	9	10	11	12						
5												
6	18	17	16	15	14	13						
7												
8	19	20	21	22	23	24						
9												
10	30	29	28	27	26	25						
11												
12	31	32	33	34	35	36						
13												

I, JONATHAN M. FIELD, in a field survey on JULY 8 19 97, do hereby certify that under requirements of P.A. 74, Michigan P.A. of 1970, the corner points mentioned in lines 1 and 2 above were in conformance with regulations and rules therefore as required in the current manual of survey instructions of the United States Department of the Interior, Bureau of Land Management or by a decree of a Court of Law and/or that the corner points mentioned in lines 3, 4 and 5 above were in conformance with the rules of the Michigan Board of Land Surveyors or by a Decree of a Court of Law; established, re-established, monumented, re-monumented, recovered, found as expressed below:


NOTE: Not more than 4 corners, all in the same town and range, may be recorded on this certificate.

A. Description of original monument and accessories and/or subsequent restoration:
1821 GLO; WAMPLER, D.S.; SET 1/4 SEC. POST IN CREEK; ASH 6 S9W 59 LKS., ELM 20 S6E 72 LKS.
1968 LEACH, LS#7236; DEL DEVELOPMENT SUBDIVISION PLAT; SHOWS CORNER AT C/L R.R.; NO OBJECT STATED; NO WITS GIVEN
1971 ROWE ENG.; ROWE, LS#11192; SURVEY L.1, PG.329-330; FND NAIL W/TAG; NORTH 2.34' N. RAIL, N20W 30.56' RR SIGN POST, S15E 22.56' RR SIGN POST
1972 CPCO; DORCEY, LS#9429; SET BOAT SPIKE BY SINGLE PROPORTION; SW 41.08' PLAT MON., SW 52.00' GAS LINE MARKER, NW 83.70' GAS LINE MARKER
1972 DORCEY, LS#9429; LCRC DENMARK TWP. PG.3; SAME OBJECT AND WITS AS 1972 CPCO SURVEY ABOVE
1983 PREVOST, LS#24612; LCRC L.1629, PG.687 ALSO BEING L.5 PG.210; FND. P-K NAIL AT C/L TRACKS PER PLAT (ON LINE BETWEEN M-9 & M-11); NORTH 2600.30' M-9, SOUTH 2649.73' M-11

B. Description of corner evidence found and/or method applied in restoring or reestablishing corner:
1997 ROWE; FIELD, PS#37276; FND. 1/2" BOAT SPIKE ON C/L REESE ROAD, NO OCCUPATION LINE TO E. OR W.; RECOVERED 2 PREVIOUS WITNESSES WHICH INDICATE THAT FND. BOAT SPIKE IS IN SAME POSITION AS 1972 CPCO SURVEY CITED IN SECTION A. ABOVE

ACCEPTED FND. BOAT SPIKE AS A CAREFUL AND FAITHFUL PERPETUATION OF THE ORIGINAL CORNER POSITION

C. Description of monument for corner and accessories established to perpetuate locating the position of the corner:
M-10 REPLACED FND. BOAT SPIKE W/ 5/8" ROD & STD. REMON. CAP IN MON. BOX
S40°W, 52.0' GAS LINE MARKER POST
N30°W, 83.7' GAS LINE MARKER POST
NORTH, 24.65' NAIL W/TAG
NORTH, 27.03' S. EDGE OF N. RAIL OF R.R. TRACKS

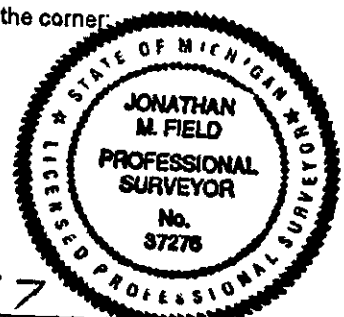

Signed by Jonathan M. Field Date 9-25-97
Surveyor's Michigan License No. 37276

FORM APPROVED BY MICHIGAN STATE BOARD OF LAND SURVEYORS, JAN. 28.
REVISED MAY 14,
REVISED JAN.,
ADAPTED FOR WORD PROCESSING MARCH,

SURVEY &
REMONUMENTATION
MAR 18 1998
SECTION