

APPROVED BY PEER GROUP
P.A. 345 OF 1990
SAGINAW COUNTY

1997 REMONUMENTATION PROGRAM
LAND CORNER RECORDATION CERTIFICATE
Filing Requirement of Act 74, Mich. P.A. 1970

RECORDED/FILED
LIBER 2028 PAGE 445
1997 OCT -3 A 8:29

MILDRED H. DODAK
REGISTER OF DEEDS
SAGINAW COUNTY, MI.

For corners in: BLUMFIELD TWP.

<u>SAGINAW</u> (County)	Located in:	Corner Code #
1. Public Land Survey	T <u>12N</u> R <u>06E</u>	<u>M-11</u>
	T _____ R _____	_____
	T _____ R _____	_____
	T _____ R _____	_____
2. Property Controlling in Section	S _____ T _____ R _____	_____
	S _____ T _____ R _____	_____
3. Miscellaneous Property in Sec.	S _____ T _____ R _____	_____
	S _____ T _____ R _____	_____
4. Lot No. _____	Recorded Plat _____	
5. Private Claims _____		

Filed 7 Page 190

Register of Deeds Stamp & File Number

1	A	B	C	D	E	F	G	H	I	J	K	L
2	6	5	4	3	2	1						
3												
4	7	8	9	10	11	12						
5												
6	18	17	16	15	14	13						
7												
8	19	20	21	22	23	24						
9												
10	30	29	28	27	26	25						
11												
12	31	32	33	34	35	36						
13												

I, JONATHAN M. FIELD, in a field survey on JULY 8 1997, do hereby certify that under requirements of P.A. 74, Michigan P.A. of 1970, the corner points mentioned in lines 1 and 2 above were in conformance with regulations and rules therefore as required in the current manual of survey instructions of the United States Department of the Interior, Bureau of Land Management or by a decree of a Court of Law and/or that the corner points mentioned in lines 3, 4 and 5 above were in conformance with the rules of the Michigan Board of Land Surveyors or by a Decree of a Court of Law, established, re-established, monumented, re-monumented, recovered, found as expressed below:


NOTE: Not more than 4 corners, all in the same town and range, may be recorded on this certificate.

A. Description of original monument and accessories and/or subsequent restoration:
1821 GLO; WAMPLER, D.S.; SET POST; MAPLE 10 IS CORNER
1957 MDOT; R.O.W. BOOK SHEET 9; M-11 T12N-R6E SHOWN; NO OBJECT STATED; NO WITS GIVEN
1968 LEACH, LS#7236; DEL DEVELOPMENT SUBDIVISION; M-11 T12N-R6E SHOWN, NO OBJECT STATED; NO WITS GIVEN
1972 CPCO; DORCEY, LS#9429; FND MON. BOX IN C/L M-46; NO WITS GIVEN
1972 DORCEY, LS#9429; LCRC DENMARK TWP. PG.4; SAME OBJECT AND WITS AS 1972 CPCO SURVEY ABOVE
1981 PREVOST, LS#24612; LCRC L.5 PG.145; BOAT SPIKE IN MON. BOX; NORTH 2.45' C/L CONC., S20E 57.00' CTR. STREET SIGN POST, N40W 49.10' CTR. STREET SIGN POST
1986 SPICER ENG.; PREVOST, LS#24612; SURVEY L.564, PG.1168; BOAT SPIKE IN MON. BOX; S20E 57.05' ST. SIGN POST, S20W 73.95' PHONE RISER, N20W 65.75' P.POLE

B. Description of corner evidence found and/or method applied in restoring or reestablishing corner:
1997 ROWE; FIELD, PS#37276; FND. BOAT SPIKE IN MON. BOX 2.5' S. OF C/L M-46 ; RECOVERED 2 PREVIOUS WITNESSES WHICH INDICATE THAT FND BOAT SPIKE IS IN SAME POSITION AS 1981 SPICER LCRC CITED IN SECTION A. ABOVE

ACCEPTED FND. BOAT SPIKE AS A CAREFUL AND FAITHFUL PERPETUATION OF THE ORIGINAL CORNER POSITION

C. Description of monument for corner and accessories established to perpetuate locating the position of the corner:
M-11 SET 5/8" ROD W/ STD. REMON. CAP OVER FND. BOAT SPIKE IN MON. BOX
N47°E, 66.15' CHIS. + ON 18" CONC. CULVERT
S45°E, 73.97' CHIS. + ON 24" CONC. CULVERT
S45°W, 36.68' 1/2" ROD W/CAP #37276
N45°W, 44.69' 1/2" ROD W/CAP #37276
S15°E, 47.70' W. EDGE OF STOP SIGN POST
S20°E, 57.05' ROAD SIGN POST
S20°W, 73.95' PHONE RISER

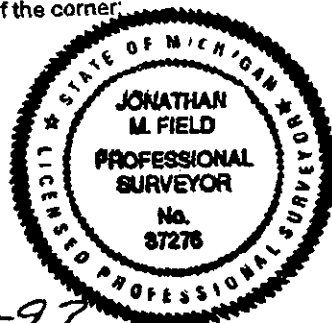

Signed by Jonathan M. Field Date 9-25-97
Surveyor's Michigan License No. 37276
SURVEY & REMONUMENTATION

FORM APPROVED BY MICHIGAN STATE BOARD OF LAND SURVEYORS, JAN. 15, 197

REVISED MAY 14, 197
REVISED JAN. 198
ADAPTED FOR WORD PROCESSING MARCH, 198

MAR 18 1998

SECTION