

Dec 14 4 07 PM '94

REGISTER OF DEEDS
SAGINAW COUNTY MICH.

APPROVED BY PEER GROUP

P.A. 345 OF 1990 SAGINAW COUNTY REMONUMENTATION PROJECT

SAGINAW COUNTY

LAND CORNER RECORDATION CERTIFICATE

Filing Requirement of Act 74, Mich. P.A. 1970

8-31-94
~~SURVEY &~~

REMONUMENTATION

For corner in Saginaw (County) Located In: Corner Code #

APR 24 1995

1. Public Land Survey	T	13N	R	3E	B-13
2. Property Controlling in Section	S	T	R		
	S	T	R		
3. Miscellaneous Property in Sec.	S	T	R		
	S	T	R		

Liber 6 Page 232

Register of Deeds Stamp & File Number

4. Lot No. _____, Recorded Plat _____
5. Private Claims _____

	A	B	C	D	E	F	G	H	I	J	K	L	M
1													
2	6	5	4	3	2	1							
3													
4	7	8	9	10	11	12							
5													
6	18	17	16	15	14	13							
7													
8	19	20	21	22	23	24							
9													
10	30	29	28	27	26	25							
11													
12	31	32	33	34	35	36							
13													

I, John H. Rauser, in a field survey on May 1994, do hereby certify that under requirements of P.A. 74, Michigan P.A. of 1970, the corner points mentioned in lines 1 and 2 above were in conformance with regulations and rules therefore as required in the current manual of survey instructions of the United States Department of the Interior, Bureau of Land Management or by a decree of a Court of Law and/or that the corner points mentioned in lines 3, 4 and 5 above were in conformance with the rules of the Michigan Board of Land Surveyors or by a Decree of a Court of Law; established, re-established, monumented, re-monumented, recovered, found as expressed below:

NOTE: Not more than 4 corners, all in the same town and range, may be recorded on this certificate.

A. Description of original monument and accessories and/or subsequent restoration:


(B-13) 1/4 Cor., Sec. 6, T12N-R3E, Section 31, T13N-R3E
Wood post placed by J. Wampler, Deputy Surveyor 1822
S81°W 17 lks (11.22') 12" Beech
N60°E 17 lks (11.22') 20" Maple
1920's Saginaw County Road Commission witnesses
1977 Saginaw County Road Commission witnesses
1991 Act 132 by Duane F. Levy, P.S. #21575, Rec. in L. 1801, Pg. 208, Saginaw County Records

B. Description of corner evidence found and/or method applied in restoring or reestablishing corner:

(B-13) 1/4 Cor., Sec. 6, T12N-R3E, Section 31, T13N-R3E
Found no evidence of original government corner. Found 1" pipe (mangled) with boat spike along N side of pipe centerline in mon. box, as per 1977 Saginaw County Road Commission witnesses and L. 1801, Pg. 208, Saginaw County Records, and is accepted as the best available evidence of the position of the original corner.

C. Description of monument for corner and accessories established to perpetuate locating the position of the corner:

(B-13) 1/4 Cor., Sec. 6, T12N-R3E, Section 31, T13N-R3E
Reset 5/8" rerod w/brass cap stamped Saginaw County Monument, P.S. #39096 in existing monument box.
N05°E 53.05' Fnd spike in washer in South fce PP
N04°E 32.98' Fnd rerod w/cap #8890
N38°W 52.47' Fnd nail w/flag SSW fce 10" Pine
South 20.9± End conc. culv.
S75°E 168.80' Set spike w/tag #39096 N fce PP
N25°W 32.63' Set chis. "+" in top 12" cnp

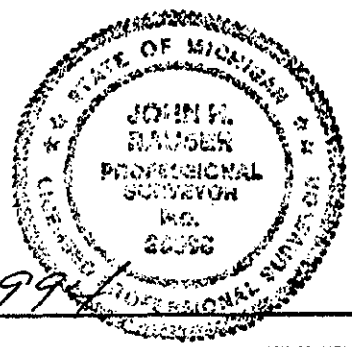

Signed by John H. Rauser
Surveyor's Michigan License No. 39096

Date Jan. 13, 1995