

APPROVED BY PEER GROUP

P.A. 345 OF 1990

SAGINAW COUNTY

COUNTY REMONUMENTATION PROJECT

LAND CORNER RECORDATION CERTIFICATE

Filing Requirement of Act 74, Mich. P.A. 1970

DEC 14 4 08 PM '94

REGISTER OF DEEDS
SAGINAW COUNTY MICH.

83-74 SURVEY &
REMONUMENTATION

For corners in

Saginaw

(County) APR 24 1995

Located In:

Corner Code #

1. Public Land Survey **COMMISSION** T 13N R 3E E-13
 T R
 T R
 T R
 T R
2. Property Controlling S T R
 in Section S T R
 3. Miscellaneous S T R
 Property in Sec. S T R
4. Lot No. _____ Recorded Plat _____
 5. Private Claims _____

Sheet 6 Page 227

Register of Deeds Stamp & File Number

I, John H. Rauser, in a field survey on May 1994, do hereby certify that under requirements of P.A. 74, Michigan P.A. of 1970, the corner points mentioned in lines 1 and 2 above were in conformance with regulations and rules therefore as required in the current manual of survey instructions of the United States Department of the Interior, Bureau of Land Management or by a decree of a Court of Law and/or that the corner points mentioned in lines 3, 4 and 5 above were in conformance with the rules of the Michigan Board of Land Surveyors or by a Decree of a Court of Law; established, re-established, monumented, re-monumented, recovered, found as expressed below:

NOTE: Not more than 4 corners, all in the same town and range, may be recorded on this certificate.

A. Description of original monument and accessories and/or subsequent restoration:

(E-13) Standard Sec. Cor., Sec. 32 & 33, T13N-R3E

Corner not set during original government survey. Fell in Indian Reserve, 1822. 1972 Act 132 by John W. Martin, P.S. #4699, Rec. in L. 1391, Pg. 476, Saginaw County Records. 1973 L.C.R.C. by John W. Martin, P.S. #4699, Rec. L. 2, Pg. 106, Saginaw County Records. 1984 Act 132 by Duane F. Ledy, P.S. #21575, Rec. in L. 1643, Pg. 1158 & L. 166, Pg. 186, Saginaw County Records. 1990 Act 132 by Duane F. Ledy, P.S. 21575, Rec. in L. 1783, Pg. 2076, Saginaw County Records.

B. Description of corner evidence found and/or method applied in restoring or reestablishing corner:


(E-13) Standard Sec. Cor., Sec. 32 & 33, T13N-R3E

Found no evidence of original government corner. Found 3/4" iron pipe in asphalt surface in centerline of Tittabawassee Road per rec. as stated in "A" above with exception of witnesses for E-13 on L. 1783, Pg. 2076, Saginaw County Records, and is accepted as the best available evidence of the position of the original corner.

C. Description of monument for corner and accessories established to perpetuate locating the position of the corner:

(E-13) Standard Sec. Cor., Sec. 32 & 33, T13N-R3E

Re-set 5/8" Re-rod w/brass cap stamped Saginaw County Monument, P.S. #39096 in C/L of Tittabawassee Road. Placed monument box flush w/pavement
S17°E 37.12' Found spike N fce PP
S17°E 37.45' Found Nail w/large washer NE fce PP
S15°E 34.60' Found re-rod w/cap #26454
N63°E 56.61' Found spike in NNW fce PP
N46°W 43.77' Found spike w/flag in E fce PP stub
West 24.23' E-1, T12N-R3E

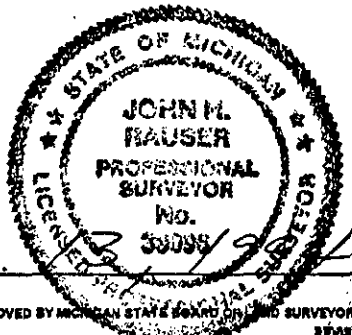

Signed by John H. Rauser Date Jan.

Surveyor's Michigan License No. 39096