

APPROVED BY PEER GROUP  
P.A. 345 OF 1990  
SAGINAW COUNTY

LIBER 1924 PAGE 1188

LAND CORNER RECORDATION CERTIFICATE  
Filing Requirement of Act 74, Mich. P.A. 1970

*Lib 6 Page 241*

RECORDED + FILED

12-13-94 *[Signature]*

DEC 15 3 55 PM '94

REGISTER OF DEEDS  
SAGINAW COUNTY MICH.

Register of Deeds Stamp & File Number

For corners in	Located In:	Corner Code #
Saginaw (County)		
1. Public Land Survey	T 13N R 3E	G-13
	T R	
	T R	
	T R	
	T R	
2. Property Controlling in Section	S T R	
	S T R	
3. Miscellaneous Property in Sec.	S T R	
	S T R	

4. Lot No. \_\_\_\_\_ Recorded Plat \_\_\_\_\_  
5. Private Claims \_\_\_\_\_

	A	B	C	D	E	F	G	H	I	J	K	L	M
1													
2	6	5	4	3	2	1							
3													
4	7	8	9	10	11	12							
5													
6	18	17	16	15	14	13							
7													
8	19	20	21	22	23	24							
9													
10	30	29	28	27	26	25							
11													
12	31	32	33	34	35	36							
13													

I, John H. Rauser, in a field survey on December 14, 1994, do hereby certify that under requirements of P.A. 74, Michigan P.A. of 1970, the corner points mentioned in lines 1 and 2 above were in conformance with regulations and rules therefore as required in the current manual of survey instructions of the United States Department of the Interior, Bureau of Land Management or by a decree of a Court of Law and/or that the corner points mentioned in lines 3, 4 and 5 above were in conformance with the rules of the Michigan Board of Land Surveyors or by a Decree of a Court of Law, established, re-established, monumented, re-monumented, recovered, found as expressed below:


NOTE: Not more than 4 corners, all in the same town and range, may be recorded on this certificate.

A. Description of original monument and accessories and/or subsequent restoration:

G-13 Standard Corner, Section 33 & 34, T13N-R3E  
Wood post placed by J. Tampler Deputy Surveyor, 1822  
S75°W 9 lks. (5.94') 12" Sugar Maple  
N37°W 8.5 lks. (5.61') 7" Elm  
No other subsequent record.

B. Description of corner evidence found and/or method applied in restoring or reestablishing corner:

G-13 Standard Corner, Section 33 & 34, T13N-R3E  
Fnd. no evidence of original government corner. GLO notes call for a falling of 115 lks. (75.9'). The corner which has been used for G-13 is 57.00 feet East of Closing Cor. G-1 (Sec. 3 & 4, T12N-R3E). Measurements to the Standard and Closing Corners East and West reflect a definite perpetuation of the original government survey. GLO calls for a 37 lks. (24.42') falling at E-1 T12N-R3E to E-13, T13N-R3E, M=24.23 feet. GLO calls for a 55 lks. (36.3') falling at I-1, T12N-R3E, to I-13, T13N-R3E, M=36.32 feet. The positions at the 1/4 corner 1/2 mile East and West of G-1/G-13 also appear to be established from a position in agreement with GLO at G-1/G-13. Measurements to fence lines at the West 1/8 line of Section 34, T13N-R3E, and the East 1/8 line of Section 33, T13N-R3E appear to agree with the GLO position at G-1/G-13.

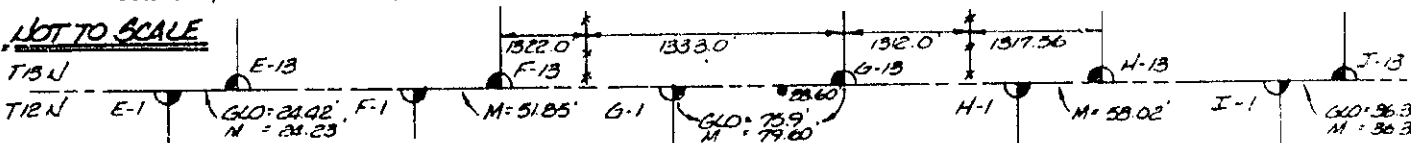


Using this information and working back to corner G-13 a jog of 79.47 feet is computed from the Westerly mile and a jog of 79.72 feet is computed from the Easterly mile. This position is consistent with the GLO call stated above and verifies the position used to set the Closing 1/4 Corners Sections 3 & 4, T12N-R3E. The position also balances the 1/8 line fence (occupation) in Sections 33 & 34, T13N-R3E. Using the position of the found 5/8" rebar and the position of I-13, T13N-R3E I placed a G-13 on line 79.60 feet East of G-1. Found Red Clay tile pieces and what appeared to be remains of wood post, black ring, dark center and pieces of wood in original soil 4' beneath road surface at this position and is accepted as a careful and faithful reestablishment of the position of the original corner.

C. Description of monument for corner and accessories established to perpetuate locating the position of the corner:

G-13 Standard Corner, Section 33 & 34, T13N-R3E  
Set 5/8" rerod w/brass cap stamped Saginaw County Monument, P.S. #39096. Placed monument box.  
N54°E 94.60' Set PK w/tag #39096 NW face Power Pole  
West 28.60' Property Controlling Corner, 3/4" pipe w/#39096 in mon. box.  
West 79.60' G-1, T12N-R3E, Saginaw County Monument  
N75°W 101.07' Fnd. PK in NE face Power Pole  
N21°E 67.65' Set spike w/tag #39096 in E. face 20" R. Pine

Signed by John H. Rauser Date Jan 14 1996  
Surveyor's Michigan License No. 39096

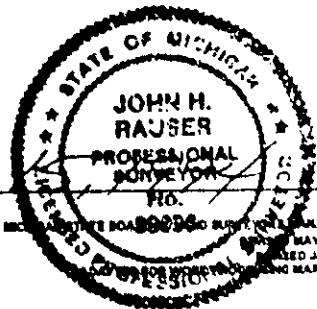

SURVEY &  
REMONUMENTATION

SURVEY &  
REMONUMENTATION

AUG 05 1996

COMMISSION

COMMISSION