

6-30 *Bluff*

SEP 28 3 16 PM '99

For corners in

MILTON J. WALK  
REGISTER OF DEEDS  
SAGINAW COUNTY MICH.

LIBER 2144 PAGE 738

*Liber 8 Page 10*

Register of Deeds Stamp & File Number

Saginaw (County) Located In: Tittabawassee Twp. Corner Code #

1. Public Land Survey T 13N R 3E K-1  
T \_\_\_\_\_ R \_\_\_\_\_  
T \_\_\_\_\_ R \_\_\_\_\_  
T \_\_\_\_\_ R \_\_\_\_\_

2. Property Controlling S \_\_\_\_\_ T \_\_\_\_\_ R \_\_\_\_\_  
in Section S \_\_\_\_\_ T \_\_\_\_\_ R \_\_\_\_\_

3. Miscellaneous S \_\_\_\_\_ T \_\_\_\_\_ R \_\_\_\_\_  
Property in Sec. S \_\_\_\_\_ T \_\_\_\_\_ R \_\_\_\_\_

4. Lot No. \_\_\_\_\_, Recorded Plat \_\_\_\_\_

5. Private Claims \_\_\_\_\_

	A	B	C	D	E	F	G	H	I	J	K	L	M
1													
2	6		5		4		3		2		1		
3													
4	7		8		9		10		11		12		
5													
6	18		17		16		15		14		13		
7													
8	19		20		21		22		23		24		
9													
10	30		29		28		27		26		25		
11													
12	31		32		33		34		35		36		
13													

I, Roger P. Mahoney, in a field survey on 8-26, 1999 do hereby state that under requirements of P.A. 74, Michigan P.A. of 1970, the corner points mentioned in lines 1 and 2 above were in conformance with regulations and rules therefore as required in the current manual of survey instructions of the United States Department of the Interior, Bureau of Land Management or by a decree of a Court of Law and /or that the corner points mentioned in lines 3, 4 and 5 above were in conformance with the rules of the Michigan Board of Land Surveyors or by a Decree of a Court of Law; established, re-established, monumented, recovered, found as expressed below:

NOTE: Not more than 2 corners, all in the same town and range, may be recorded on this certificate.

A. Description of original monument and accessories and/or subsequent restoration:

K-1 Post set by D.S. Joseph Wampler, 1822.  
North between Sec's 1 & 2, 77.27 intersect N. boundary 69 links.  
West of Post. Set post at intersection.  
Beech 9" N.53°E. 17 Lks.  
Lynn 8" S.71°W. 3 Lks.

SURVEY &  
REMONUMENTATION

MAR 09 2000

SECTION

B. Description of corner evidence found and/or method applied in restoring or reestablishing corner:

K-1 Nothing Found  
Sag. Co. Rd. Comm Notes 1974 found 3/4" pipe. This actually the corner K-13, T.14 N.-R.3 E.  
Act 132 L1801 P307, Ledy, 1990, shows K-1 as being 45.54' West of K-13, T.14 N.-R.3 E.  
(69 Links = 45.54') but no point found.  
Spicer notes of 1996 K-1 not found.  
Act 132 L1518 P252, MacDonald, 1977 shows corner K-1, no witnesses or distances.


Set corner 45.54' West of K-13, T.14 N.-R.3 E. and on line between K-13 and J-13 of T.14 N.-R.3 E., and is accepted as the best available evidence of the position of the original corner.

C. Description of monument for corner and accessories established to perpetuate locating the position of the corner:

K-1 Set 5/8" rod, Re-mon cap stamped #24612 & mon box, 45.54' West of K-13, T.14 N.-R.3 E., and on line between K-13 & J-13 T.14 N.-R.3 E.  
N.78° E. 119.11 nail & tag N. side P. pole.  
East 45.54 corner K-13, T.14 N.-R.3 E. Re-mon rod & cap  
N.14°W. 79.48 SE corner concrete foundation house.  
S.20°W. 112.83 SE'ly corner block foundation house.

Signed by Roger P. Mahoney  
Roger P. Mahoney

Date 9-21-99

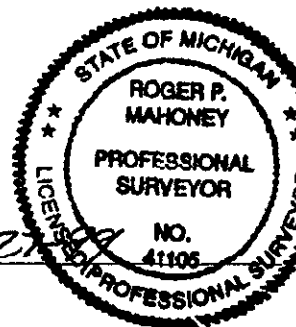

Surveyor's Michigan License No. 41105