

APPROVED BY PEER GROUP  
P.A. 345 OF 1990  
SAGINAW COUNTY  
**SAGINAW COUNTY REMONUMENTATION 1999**  
**LAND CORNER RECORDATION CERTIFICATE**  
Filing Requirement of Act 74, Mich. P.A. 1970

RECORDED & FILED

SEP 28 3 16 PM '99

MICHIGAN  
REGISTER OF DEEDS  
SAGINAW COUNTY MICH.

LIBER 2144 PAGE 734

*Liber 8 Page 6*

Register of Deeds Stamp & File Number

For corners in

<u>Saginaw</u> (County)	Located In:	Corner Code #
	<u>Tittabawassee Twp.</u>	
1. Public Land Survey	T <u>13N</u> R <u>3E</u>	<u>M-3</u>
	T _____ R _____	_____
	T _____ R _____	_____
	T _____ R _____	_____
2. Property Controlling	S _____ T _____ R _____	_____
in Section	S _____ T _____ R _____	_____
3. Miscellaneous	S _____ T _____ R _____	_____
Property in Sec.	S _____ T _____ R _____	_____
4. Lot No. _____, Recorded Plat _____		
5. Private Claims _____		

I, Roger P. Mahoney, in a field survey on 3-31, 1999 do hereby state that under requirements of P.A. 74, Michigan P.A. of 1970, the corner points mentioned in lines 1 and 2 above were in conformance with regulations and rules therefore as required in the current manual of survey instructions of the United States Department of the Interior, Bureau of Land Management or by a decree of a Court of Law and /or that the corner points mentioned in lines 3, 4 and 5 above were in conformance with the rules of the Michigan Board of Land Surveyors or by a Decree of a Court of Law; established, re-established, monumented, recovered, found as expressed below:

**NOTE:** Not more than 2 corners, all in the same town and range, may be recorded on this certificate.

	A	B	C	D	E	F	G	H	I	J	K	L	M
1													
2	6	5	4	3	2	1							
3													
4	7	8	9	10	11	12							
5													
6	18	17	16	15	14	13							
7													
8	19	20	21	22	23	24							
9													
10	30	29	28	27	26	25							
11													
12	31	32	33	34	35	36							
13													

A. Description of original monument and accessories and/or subsequent restoration:

M-3 Post set by D.S. Joseph Wampler, 1822.  
Elm 32" N.70°W. 2 Lks.  
W Oak 22" N.14°E. 4 1/2 Lks.  
West between Sec's 6 & 7, T.13 N.-R.4 E., 71.12 chains intersect W. bndry at post.  
Spicer Eng. notes of 1971 1/4" rod.  
LCRC L001 P529, Goss 3/8" iron rec'd as A-3, T.13 N.-R.4 E. common cor.  
LCRC L3 P206 McGinnis 3/8" rod.  
LCRC L4 P196 Prevost 3/4" pipe set in place of 1/4" rod from 1971 notes.


B. Description of corner evidence found and/or method applied in restoring or reestablishing corner:

M-3 Found 3/4" pipe in mon box. Also found bent 3/8" rod 2.7' West & 0.15' South.  
LCRC L001 P529, Goss, appear to be for W 1/4 point.  
Act 132 L1416 PG1168 appears to be for W 1/4 point, McGinnis.  
LCRC L3 P206 McGinnis appear to be for E 1/4 point.  
LCRC L4 P196 Prevost 3/4" pipe wits for E 1/4 point.

Monument accepted as the best available evidence of the position of the original corner.

C. Description of monument for corner and accessories established to perpetuate locating the position of the corner:

M-3 Replaced 3/4" pipe with 5/8" bar & Saginaw County re-mon cap stamped #24612 in existing mon box.  
S.55°E. 129.97 nail & tag N. face P. pole, (record 129.9 L4 P196)(record 129.7 L3 P206).  
S.75°W. 73.47 nail & tag S. face P. pole, (record 73.22 L4 P196)(record 72.85 pole L3 P206).  
S.40°W. 192.33 NE corner brick house.  
N.65°E. 40.20 top center telephone ped.

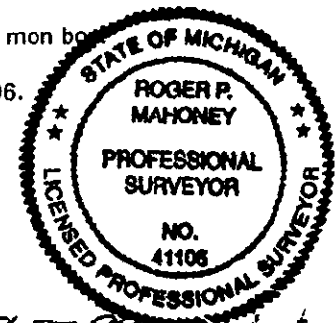

Signed by Roger P. Mahoney  
Roger P. Mahoney  
Surveyor's Michigan License No. 41106

Date 9-27-99