

APPROVED BY PEER GROUP
P.A. 345 OF 1990
SAGINAW COUNTY

SAGINAW COUNTY REMONUMENTATION 1999
LAND CORNER RECORDATION CERTIFICATE
Filing Requirement of Act 74, Mich. P.A. 1970

RECORDED & FILED

9-1 BDF
For corners in

SEP 28 3 16 PM '99

MICHIGAN DEEDS
REGISTER OF DEEDS
SAGINAW COUNTY MICH.

LIBER 2144 PAGE 733

Lib 8 Page 5

Register of Deeds Stamp & File Number

<u>Saginaw</u> (County)	Located In: <u>Tittabawassee Twp.</u>	Corner Code # _____
1. Public Land Survey	T <u>13N</u> R <u>3E</u>	<u>M-4</u>
	T _____ R _____	_____
	T _____ R _____	_____
	T _____ R _____	_____
2. Property Controlling	S _____ T _____ R _____	_____
in Section	S _____ T _____ R _____	_____
3. Miscellaneous	S _____ T _____ R _____	_____
Property in Sec.	S _____ T _____ R _____	_____

4. Lot No. _____, Recorded Plat _____
5. Private Claims _____

I, Roger P. Mahoney, in a field survey on 4-6, 1999 do hereby state that under requirements of P.A. 74, Michigan P.A. of 1970, the corner points mentioned in lines 1 and 2 above were in conformance with regulations and rules therefore as required in the current manual of survey instructions of the United States Department of the Interior, Bureau of Land Management or by a decree of a Court of Law and for that the corner points mentioned in lines 3, 4 and 5 above were in conformance with the rules of the Michigan Board of Land Surveyors or by a Decree of a Court of Law; established, re-established, monumented, recovered, found as expressed below:

NOTE: Not more than 2 corners, all in the same town and range, may be recorded on this certificate.

	A	B	C	D	E	F	G	H	I	J	K	L	M
1													
2		6		5		4		3		2		1	
3													
4		7		8		9		10		11		12	
5													
6		16		17		16		15		14		13	
7													
8		19		20		21		22		23		24	
9													
10		30		29		28		27		26		25	
11													
12		31		32		33		34		35		36	
13													

A. Description of original monument and accessories and/or subsequent restoration:

M-4 Post set by D.S. Joseph Wampler, 1822.
Ash 18° S.81°W., 8 Lks.
Maple 10° N.44°E., 10 Lks.
Spicer Eng. notes, 1971, R.R. spike set, no witnesses, on line between M-3 & M-5,
2619.62 S. of M-3, 2627.70 N. of M-5.

B. Description of corner evidence found and/or method applied in restoring or reestablishing corner:

M-4 R.R. spike gone, set mag-nail by repeating the alignment & measurements from 1971 Spicer notes. Found new P.K. nail 0.25' West & 0.52' South of re-set mag-nail.
LCRC L4 P196 Prevost, 1978, R.R. spike. Witnesses gone.
SCRC notes 1979 R.R. spike. Placed mon box. witness gone.

Monument accepted as the best available evidence of the position of the original corner.


C. Description of monument for corner and accessories established to perpetuate locating the position of the corner:

M-4 Replaced mag-nail with 5/8" rod, Sag. Co. re-mon cap stamped #24612 & mon box.
S.75°W. 57.61 mag-nail N. face P. pole.
S.70°W. 100.35 NE cor. brick house #9490.
N.85°W. 25.74 chisled + W. end 30" C.M.P.
S.85°E. 25.68 chisled + E. end 30" C.M.P.

SURVEY &
REMONUMENTATION

MAR 09 2000

SECTION

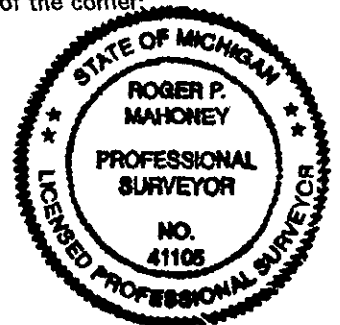

Signed by Roger P. Mahoney
Roger P. Mahoney
Surveyor's Michigan License No. 41105

Date 9-27-99