

APPROVED BY PEER GROUP
P.A. 345 OF 1990

SAGINAW COUNTY REMONUMENTATION 1999
LAND CORNER RECORDATION CERTIFICATE
Filing Requirement of Act 74, Mich. P.A. 1970

RECORDED & FILED

SAGINAW COUNTY
6-30 BLP

SEP 28 3 16 PM '99

For corners in

MICHIGAN
REGISTER OF DEEDS
SAGINAW COUNTY MICH.

LIBER 2144 PAGE 731

<u>Saginaw</u> (County)	Located In: <u>Tittabawassee Twp.</u>	Corner Code # <u>M-11</u>
1. Public Land Survey	T <u>13N</u> R <u>3E</u>	<u>M-11</u>
	T _____ R _____	_____
	T _____ R _____	_____
	T _____ R _____	_____
2. Property Controlling	S _____ T _____ R _____	_____
in Section	S _____ T _____ R _____	_____
3. Miscellaneous	S _____ T _____ R _____	_____
Property in Sec.	S _____ T _____ R _____	_____
4. Lot No. _____, Recorded Plat _____		
5. Private Claims _____		

Liber 8 Page 3
Register of Deeds Stamp & File Number

I, Roger P. Mahoney, in a field survey on 4-6, 1999 do hereby state that under requirements of P.A. 74, Michigan P.A. of 1970, the corner points mentioned in lines 1 and 2 above were in conformance with regulations and rules therefore as required in the current manual of survey instructions of the United States Department of the Interior, Bureau of Land Management or by a decree of a Court of Law and /or that the corner points mentioned in lines 3, 4 and 5 above were in conformance with the rules of the Michigan Board of Land Surveyors or by a Decree of a Court of Law; established, re-established, monumented, recovered, found as expressed below:

NOTE: Not more than 2 corners, all in the same town and range, may be recorded on this certificate.

	A	B	C	D	E	F	G	H	I	J	K	L	M
1													
2		6		5		4		3		2		1	
3													
4		7		8		9		10		11		12	
5													
6		18		17		16		15		14		13	
7													
8		19		20		21		22		23		24	
9													
10		30		29		28		27		26		25	
11													
12		31		32		33		34		35		36	
13													

A. Description of original monument and accessories and/or subsequent restoration:

M-11 Post set by D.S. Joseph Wampler, 1822.
Beech 11" S 2 E. 27 Lks.
Maple 15" N.65°W. 36 Lks.


B. Description of corner evidence found and/or method applied in restoring or reestablishing corner:

M-11 Found 3/4" pipe in agreement with LCRC L1 P87 wits & SCRC wits, and Spicer tie in 1968 survey.
Spicer Eng. notes 1968 found 3/4" pipe.
LCRC L1 P87 sides 1971 found 3/4" pipe.
SCRC notes 1974 found 3/4" pipe.
Act 132 L1555 P1262 found 3/4" pipe, 1978.
Spicer notes 1977 3/4" pipe.

Monument accepted as the best available evidence of the position of the original corner.

C. Description of monument for corner and accessories established to perpetuate locating the position of the corner:

M-11 Replaced 3/4" pipe with 5/8" rod, Saginaw County re-mon cap stamped #24612 & set mon box.
North 71.90 ctr. 1 1/2" pipe A-11 T.13 N.-R.4 E. (record 71.94 Spicer 1968)(71.88 SCRC)
N.85°E. 89.50 nail & tag N. face P. pole. (record 89.5 L1 Pg 87)(89.60 SCRC).
N.30°W. 52.73 set nail & tag NE side U.P. (record 52.90 L1 P 87)(52.56 SCRC).
N.30°E. 138.25 set nail & tag SE side 36" Maple.

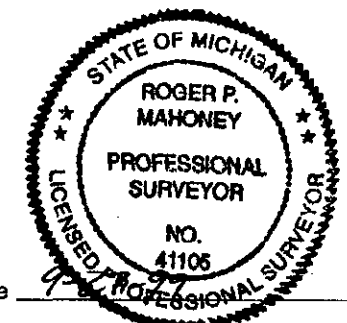

Signed by Roger P. Mahoney
Roger P. Mahoney

Date 9/28/99

Surveyor's Michigan License No. 41105