

APPROVED BY PEER GROUP  
P.A. 345 OF 1990  
SAGINAW COUNTY

SAGINAW COUNTY REMONUMENTATION 1999  
LAND CORNER RECORDATION CERTIFICATE  
Filing Requirement of Act 74, Mich. P.A. 1970

SEP 28 3 16 PM '99

MICHIGAN REGISTER OF DEEDS  
SAGINAW COUNTY MICH.

LIBER 2144 PAGE 729

*Liber 8 Page 1*


Register of Deeds Stamp & File Number

For corners in

<u>Saginaw</u> (County)	Located In: <u>Tittabawassee Twp.</u>	Corner Code #
1. Public Land Survey	T <u>13N</u> R <u>3E</u>	<u>M-12</u>
	T _____ R _____	_____
	T _____ R _____	_____
	T _____ R _____	_____
2. Property Controlling	S _____ T _____ R _____	_____
in Section	S _____ T _____ R _____	_____
3. Miscellaneous	S _____ T _____ R _____	_____
Property in Sec.	S _____ T _____ R _____	_____
4. Lot No. _____, Recorded Plat _____		
5. Private Claims _____		

I, Roger P. Mahoney, in a field survey on 4-6, 1999 do hereby state that under requirements of P.A. 74, Michigan P.A. of 1970, the corner points mentioned in lines 1 and 2 above were in conformance with regulations and rules therefore as required in the current manual of survey instructions of the United States Department of the Interior, Bureau of Land Management or by a decree of a Court of Law and for that the corner points mentioned in lines 3, 4 and 5 above were in conformance with the rules of the Michigan Board of Land Surveyors or by a Decree of a Court of Law; established, re-established, monumented, recovered, found as expressed below:

NOTE: Not more than 2 corners, all in the same town and range, may be recorded on this certificate.

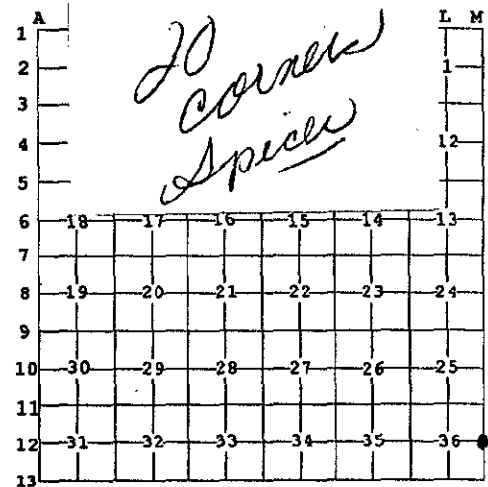

A. Description of original monument and accessories and/or subsequent restoration:

M-12 Post set by D.S. Joseph Wampler, 1822.  
Ash 16" S.35°W. 15 Lks.  
Maple 20" N.51°E. 11 Lks.

B. Description of corner evidence found and/or method applied in restoring or reestablishing corner:


M-12 Found 1" pipe 6" below bit.  
Act 132 L1555 P1262 3/4" pipe 1976.  
Spicer notes 1977 1" pipe.  
Consumers Power Co. map 1957 iron N.32.8' to A-12, T.13 N.-R.4 E.

Monument accepted as the best available evidence of the position of the original corner.

C. Description of monument for corner and accessories established to perpetuate locating the position of the corner:

M-12 Removed 1" pipe found frost pin (iron pin) under, set 5/8" bar with Saginaw County re-mon cap stamped #24612 & mon box in place of 1" pipe & iron pin.  
S.60°W. 62.98 NE leg of tower @ splice. (record 62.98 Spicer notes 1977)(62.6 L1555 P1262).  
S.45°W. 80.62 SE leg of tower @ splice. (record 80.7 L1555 P1262).  
S.85°W. 23.55 chisled + on top W. end 48" conc. culv.  
S.65°E. 20.40 chisled + on top E. end 48" conc. culv.  
North 32.89 to A-12, T.13 N.-R.4 E. 3/4" pipe (record 32.8).

SURVEY &  
REMONUMENTATION  
MAR 09 2000  
SECTION

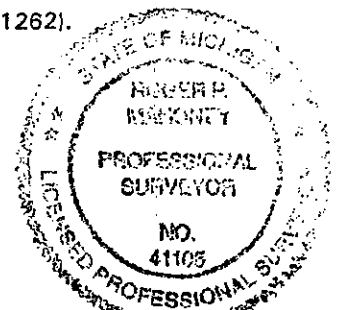

Signed by Roger P. Mahoney  
Roger P. Mahoney  
Surveyor's Michigan License No. 41105

Date 9-27-99