

Saginaw County Remonumentation

LAND CORNER RECORDATION CERTIFICATE
Filing Requirement of Act 74, Mich. P.A. 1970

Liber 7 Page 85

For corners in

<u>Saginaw</u> (County)	Located In:	Corner Code #
Kochville Township		
1. Public Land Survey	T <u>13NR</u> 4E	<u>A-7</u>
	T ___ R ___	_____
	T ___ R ___	_____
	T ___ R ___	_____
2. Property Controlling in Section	S ___ T ___ R ___	_____
	S ___ T ___ R ___	_____
3. Miscellaneous Property in Sec.	S ___ T ___ R ___	_____
	S ___ T ___ R ___	_____

HILDRED H. DOAK
REGISTER OF DEEDS
SAGINAW COUNTY MICH.

SEP 27 11 45 AM 1996

RECORDED & FILED

Register of Deeds Stamp & File Number

4. Lot No. _____, Recorded Plat _____
5. Private Claims _____

I, Michael J. MacDonald, in a field survey on August 20, 1996 do hereby state that under requirements of P.A. 74, Michigan P.A. of 1970, the corner points mentioned in lines 1 and 2 above were in conformance with regulations and rules therefore as required in the current manual of survey instructions of the United States Department of the Interior, Bureau of Land Management or by a decree of a Court of Law and/or that the corner points mentioned in lines 3, 4 and 5 above were in conformance with the rules of the Michigan Board of Land Surveyors or by a Decree of a Court of Law; established, re-established, monumented, recovered, found as expressed below:

NOTE: Not more than 2 corners, all in the same town and range, may be recorded on this certificate.

	A	B	C	D	E	F	G	H	I	J	K	L	M
1													
2		6		5		4		3		2		1	
3													
4		7		8		9		10		11		12	
5													
6		18		17		16		15		14		13	
7													
8		19		20		21		22		23		24	
9													
10		30		29		28		27		26		25	
11													
12		31		32		33		34		35		36	
13													

A. Description of original monument and accessories and/or subsequent restoration:

A-7 J. Wampler D.S. in 1822 intersected the standard line 49 links N of M-7, T13N, R3E.

L.C.R.C. - L. 2, P. 241.


B. Description of corner evidence found and/or method applied in restoring or reestablishing corner:

A-7 No evidence of corner found L.C.R.C. L. 2, P. 241, apparently witnesses to position of M-7, T13N, R3E. Occupation lines along the W side of NW 1/4 of Sec 19, T13N, R4E, appears to indicate that M-7, T13N, R3E, has been used as a corner common with A-7, T13N, R4E. Reset M-7 at GLO distance 32.34' (49 links) N of M-7 on line between M-7 and M-6, T13N, R3E.

C. Description of monument for corner and accessories established to perpetuate locating the position of the corner:

A-7 Bay County Remonumentation cap on 5/8" x 24" rebar in monument box.

S 80° W 58.09' to nail and tag in NE face of pole.
N 30° E 54.00' to nail and tag in NW face of wood guard rail post.
N 35° W 87.56' to nail and tag in SW face of 14" twin Ash.
S 10° E 115.32' to nail and tag in W face of 18" Ash.

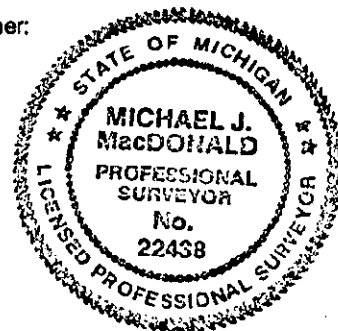

Signed by Michael J. MacDonald
Surveyor's Michigan License No. 22438

Date 25 Sept 96

MAY 13 1997