

APPROVED BY PEER GROUP
 P.A. 345 OF 1990
 SAGINAW COUNTY
SAGINAW COUNTY REMONUMENTATION 1999
LAND CORNER RECORDATION CERTIFICATE
 Filing Requirement of Act 74, Mich. P.A. 1970

RECORDED & FILED

SEP 28 3 16 PM '99

MICHIGAN
 REGISTER OF DEEDS
 SAGINAW COUNTY MICH.

LIBER 2144 PAGE 730

Liber 8 Page 2

Register of Deeds Stamp & File Number

For corners in

<u>Saginaw</u> (County)	Located In: <u>Kochville Twp.</u>	Corner Code # <u>A-10</u>
1. Public Land Survey	T <u>13N</u> R <u>4E</u>	<u>A-10</u>
	T _____ R _____	_____
	T _____ R _____	_____
	T _____ R _____	_____
2. Property Controlling	S _____ T _____ R _____	_____
in Section	S _____ T _____ R _____	_____
3. Miscellaneous	S _____ T _____ R _____	_____
Property in Sec.	S _____ T _____ R _____	_____
4. Lot No. _____, Recorded Plat _____		
5. Private Claims _____		

	A	B	C	D	E	F	G	H	I	J	K	L	M
1													
2	6		5		4		3		2		1		
3													
4	7		8		9		10		11		12		
5													
6	18		17		16		15		14		13		
7													
8	19		20		21		22		23		24		
9													
10	30		29		28		27		26		25		
11													
12	31		32		33		34		35		36		
13													

I, Roger P. Mahoney, in a field survey on 9-23, 1999 do hereby state that under requirements of P.A. 74, Michigan P.A. of 1970, the corner points mentioned in lines 1 and 2 above were in conformance with regulations and rules therefore as required in the current manual of survey instructions of the United States Department of the Interior, Bureau of Land Management or by a decree of a Court of Law and /or that the corner points mentioned in lines 3, 4 and 5 above were in conformance with the rules of the Michigan Board of Land Surveyors or by a Decree of a Court of Law; established, re-established, monumented, recovered, found as expressed below:

NOTE: Not more than 2 corners, all in the same town and range, may be recorded on this certificate.

A. Description of original monument and accessories and/or subsequent restoration:

A-10 Post not set in Gov't survey.
 Spicer Eng. notes 1966 no corner found.


B. Description of corner evidence found and/or method applied in restoring or reestablishing corner:

A-10 No corner found.
 Act 132 L1922 P1099, Ledy 1995, shows and witnesses a 3/4" pipe found and labeled W 1/4 cor. Sec. 30, T.13 N.-R.4 E., but pt. is E 1/4 cor. Sec. 25, T.13 N.-R.3 E.
 Set temporary point for A-10 on Township line between M-9 & M-11, T.13 N.-R.3 E., and mid-way between A-9 and A-11, T.13 N.-R.4 E.
 Dug down and found nail and shinner near surface of road near location of temporary point for A-10.
 Accepted the temporary point as the best position for corner.

C. Description of monument for corner and accessories established to perpetuate locating the position of the corner:

A-10 Set 5/8" rod, Sag. Co. re-mon cap stamped #24612 and mon box.
 South 71.04 re-mon cap #24612 in mon box.
 S.15°W. 71.52 1 1/2" pipe at bit surface.
 S.30°E. 45.20' cut North on E end 42" C.M.P.
 S.30°W. 45.92' cut notch on W. end 42" C.M.P.

SURVEY &
 RE
 MAR 19 2006
 SECTION

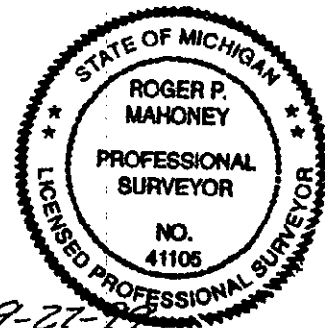

Signed by Roger P. Mahoney
 Roger P. Mahoney

Date 9-27-99

Surveyor's Michigan License No. 41105