

APPROVED BY PEER GROUP
 P.A. 345 OF 1990
 SAGINAW COUNTY
 SAGINAW COUNTY REMONUMENTATION 1999
 LAND CORNER RECORDATION CERTIFICATE
 Filing Requirement of Act 74, Mich. P.A. 1970

RECORDED & FILED

10-30 [Signature]

For corners in

<u>Saginaw</u> (County)	Located In: <u>Kochville Twp.</u>	Corner Code #
1. Public Land Survey	T <u>13N</u> R <u>4E</u>	<u>A-11</u>
	T _____ R _____	_____
	T _____ R _____	_____
	T _____ R _____	_____
2. Property Controlling	S _____ T _____ R _____	_____
in Section	S _____ T _____ R _____	_____
3. Miscellaneous	S _____ T _____ R _____	_____
Property in Sec.	S _____ T _____ R _____	_____
4. Lot No. _____, Recorded Plat _____		
5. Private Claims _____		

SEP 28 3 16 PM '99

MICHIGAN REGISTER OF DEEDS
 SAGINAW COUNTY MICH.

LIBER 2144 PAGE 747

Liber 8 Page 19

Register of Deeds Stamp & File Number

I, Roger P. Mahoney, in a field survey on 4-6, 1999 do hereby state that under requirements of P.A. 74, Michigan P.A. of 1970, the corner points mentioned in lines 1 and 2 above were in conformance with regulations and rules therefore as required in the current manual of survey instructions of the United States Department of the Interior, Bureau of Land Management or by a decree of a Court of Law and for that the corner points mentioned in lines 3, 4 and 5 above were in conformance with the rules of the Michigan Board of Land Surveyors or by a Decree of a Court of Law; established, re-established, monumented, recovered, found as expressed below:

NOTE: Not more than 2 corners, all in the same town and range, may be recorded on this certificate.

A	B	C	D	E	F	G	H	I	J	K	L	M
1												
2	6	5	4	3	2	1						
3												
4	7	8	9	10	11	12						
5												
6	18	17	16	15	14	13						
7												
8	19	20	21	22	23	24						
9												
10	30	29	28	27	26	25						
11												
12	31	32	33	34	35	36						
13												

A. Description of original monument and accessories and/or subsequent restoration:

A-11 Post set by D.S. Joseph Wampler 1822.
 West between 30 & 31 72.18 intersected W. boundary 1.09 N. of post.
 Set post at intersection 1.09 = 71.90'.
 Beech 9° N. 3° E. 12 Lks.
 Beech 10° S. 31° E. 37 Lks.

B. Description of corner evidence found and/or method applied in restoring or reestablishing corner:

A-11 Found 1 1/2" pipe @ bit surface, previous witnesses & distances support position.
 Consumers Power Co. map 1957, stone & steel fence post.
 Spicer Eng. notes 1966 found 2" pipe.
 SCRC notes 1974 found 1 1/2" pipe.

Monument accepted as the best available evidence of the position of the original corner.


C. Description of monument for corner and accessories established to perpetuate locating the position of the corner:

A-11 Removed 1 1/2" pipe found it to be over large stone vertical in ground & surrounded by cinder bricks.
 Set 5/8" bar Saginaw County re-mon cap stamped #24612 & mon box in place of 1 1/2" pipe.
 South 71.90 3/4" pipe @ surf. M-11 T.13 N.-R.3 E.
 N.50°E. 75.34 nail & tag SE side 36" Maple (record 74.54 spike in S root 24" Maple-SCRC).
 S.50°W. 46.06 set nail & tag NE side U. pole stub (record 46.15 face pole Spicer 1966).
 S.50°E. 109.80 nail & tag N. side P. pole (record 109.93 SCRC 1974).

SURVEY &
 RECONSTRUCTION

MAR 09 2000

SECTION

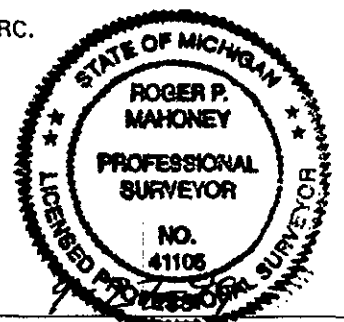

Signed by Roger P. Mahoney
 Roger P. Mahoney
 Surveyor's Michigan License No. 41105

Date _____